



T.13S.,R.30E.,W.M.

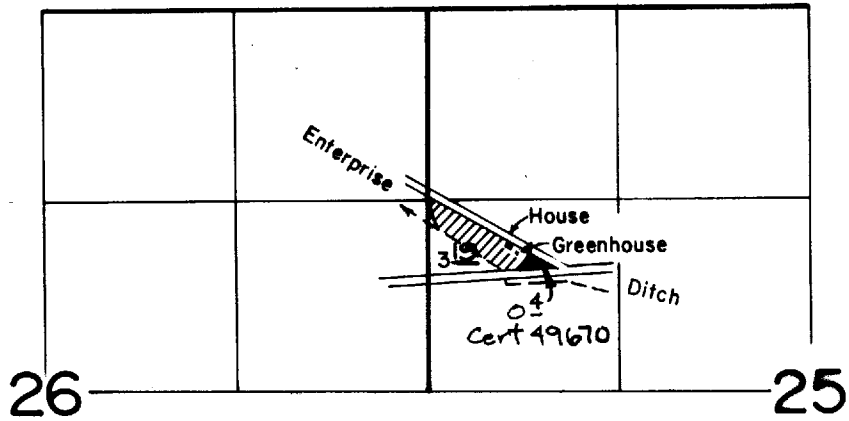

T.13S.,R.31E.,W.M.

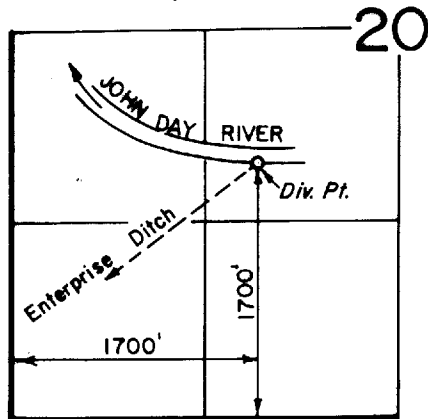

**FINAL PROOF SURVEY**  
UNDER

Application No. 57333 Permit No. 43318  
IN NAME OF

RICHARD C. WEAVER

Surveyed JUNE 17, 1980, by [Signature]