


RECEIVED

AUG 19 1996

WATER RESOURCES DEPT.
SALEM, OREGON

T. 4 N., R. 20 E., W.M.

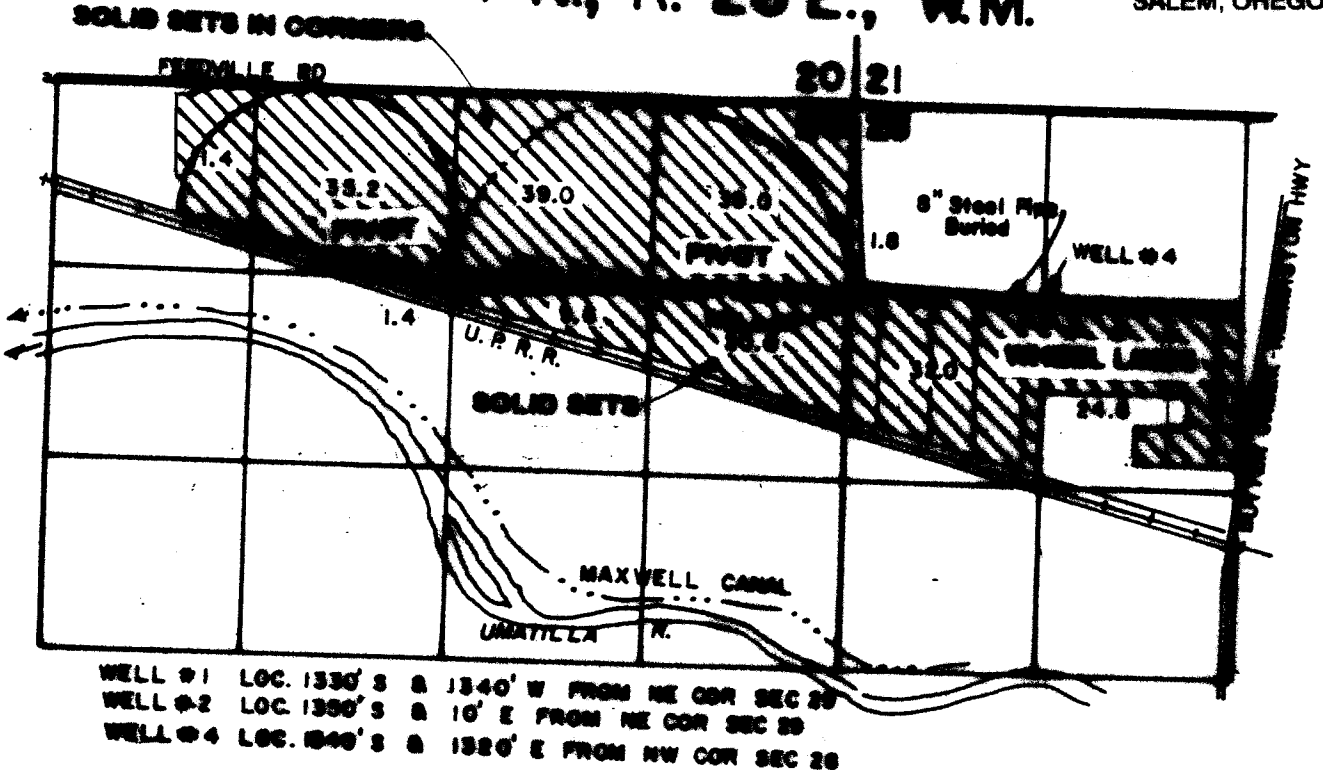

FINAL PROOF SURVEY

UNDER

T-7102

Application No. G-5304

Permit No. G-9044

IN NAME OF

RONALD R. & JANE I. BAKER

SCALE 1" = 100'

THIS MAP IS FOR THE PURPOSE
OF IDENTIFYING THE LOCATION
OF WATER RIGHTS ONLY AND IS
NOT INTENDED TO PROVIDE
LEGAL DETERMINATION OR LOCATIONS
OF PROPERTY OWNERSHIP LINES.

