


T1N, R4W, W1M

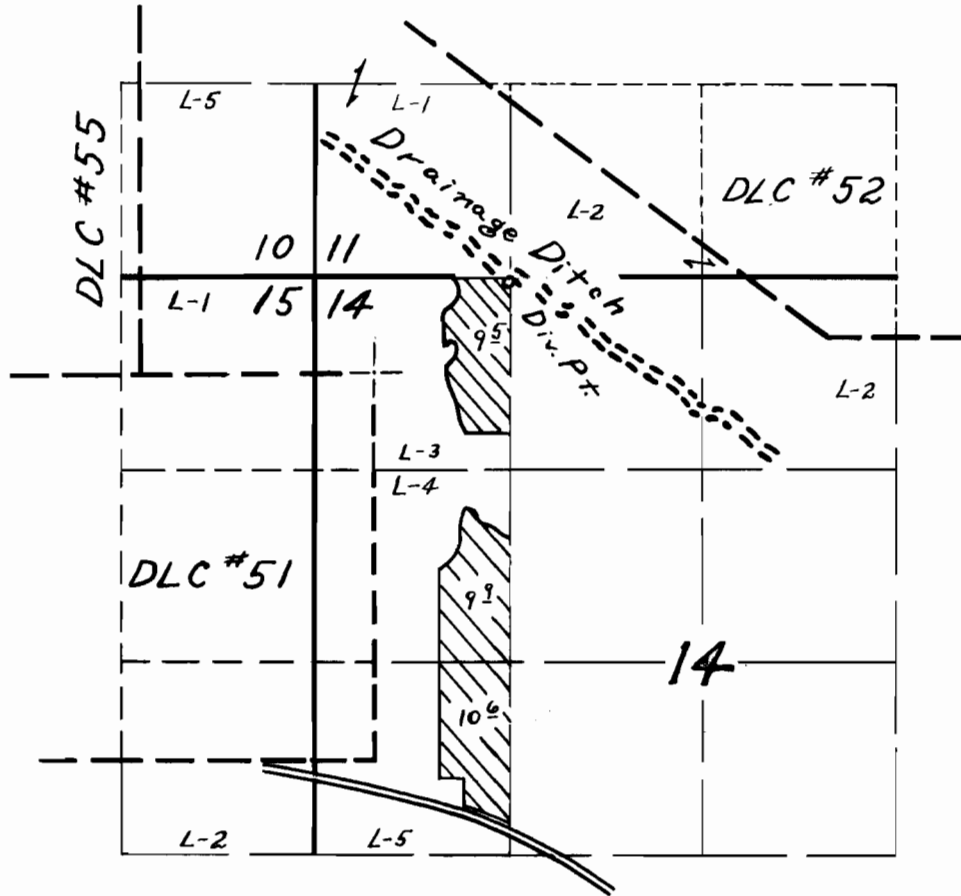

FINAL PROOF SURVEY

UNDER

Application No. 25509 Permit No. 20040

IN NAME OF

.....Walter S. Willis.....

Surveyed 4-13, 1956 by R.D. Best.....