


T. 1 N., R. 4 W. W.M.

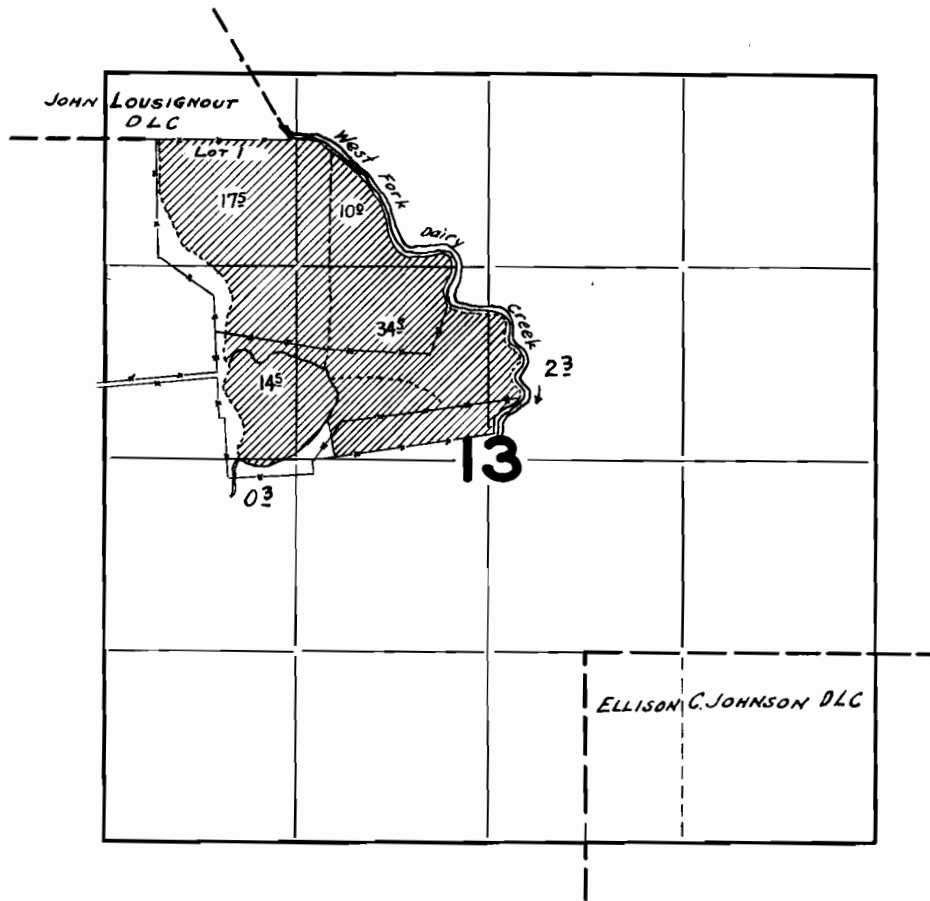

FINAL PROOF SURVEY UNDER

Application No. 17701 Permit No. 13387

IN NAME OF

Ernest Heesacker

Surveyed Aug. 10 1942, by Scott Adelman