


T. 1 N. R. 3 W. W. M.

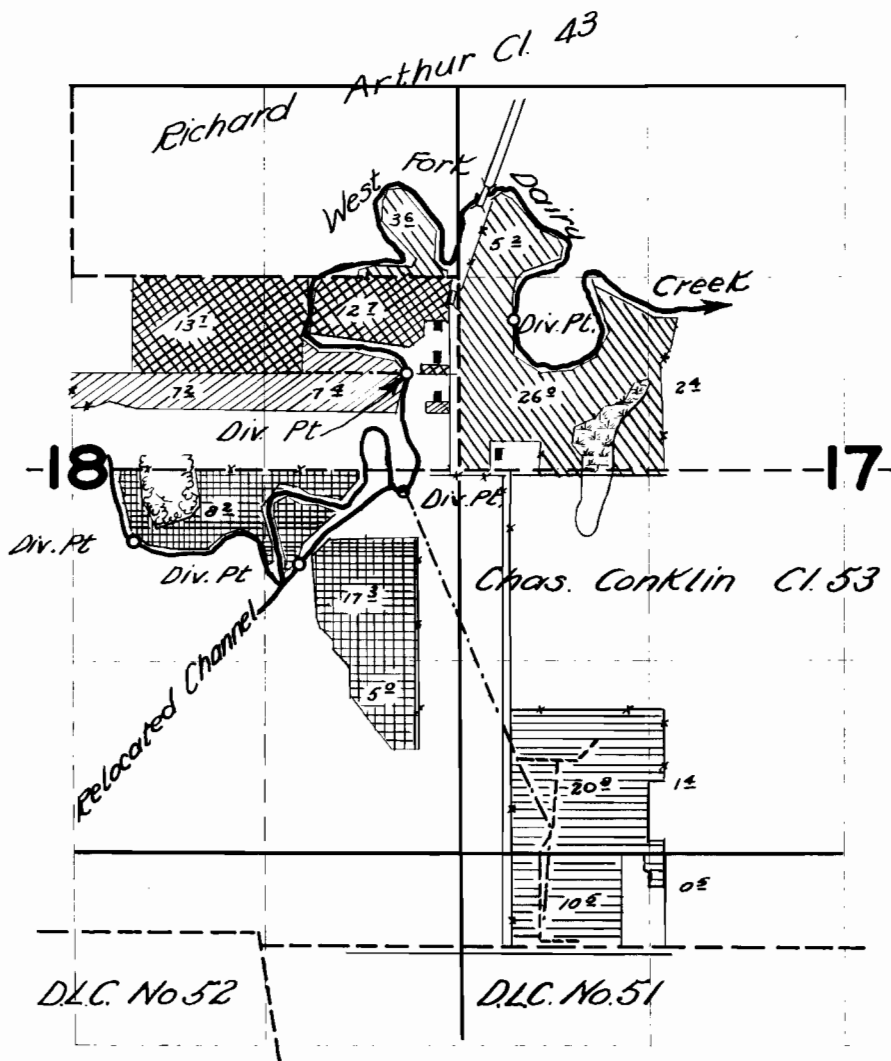

FINAL PROOF SURVEY

UNDER

W. J. VANDERZANDEN APP. 22889 PER. 17997



W. J. VANDERZANDEN APP. 19857 PER. 15436



CLARENCE VAN DYKE APP. 20055 PER. 15621



EDWARD KINDEL APP. 21407 PER. 16759



ALBERT J. EVERS APP. 22279 PER. 17570



SURVEYED AUG. 13 1951

H. L. COFFMAN