


# T. IN. & IS. R. 4W.W.M.

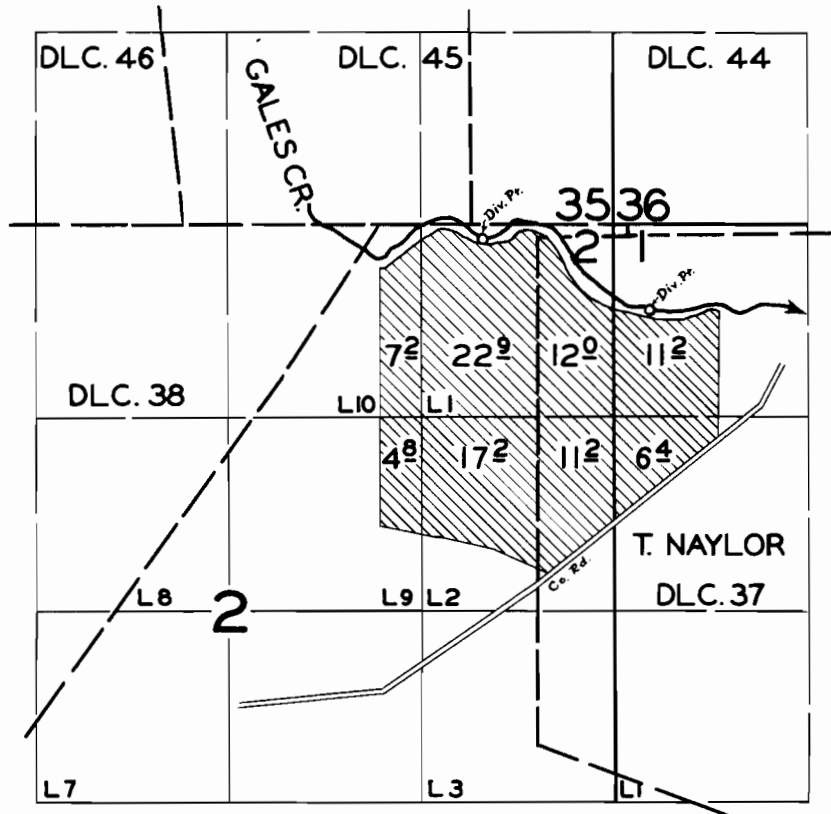

## FINAL PROOF SURVEY UNDER

Application No. 29759 Permit No. 23438  
IN NAME OF

MYRON SHEELAR

Surveyed JUNE 2, 1959, by M. BISH