


T. 1 N., R. 4 W. W.M.

RECEIVED

MAR 31 2005

WATER RESOURCES DEPT
SALEM, OREGON

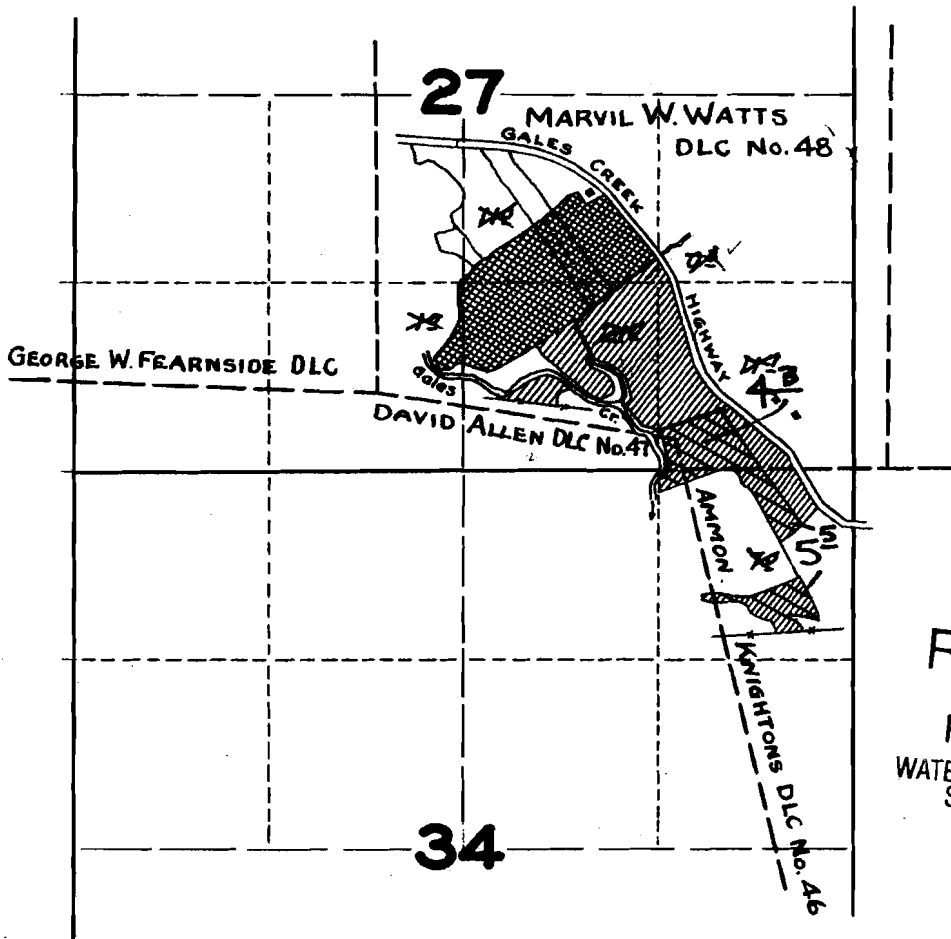

RECEIVED

FEB 28 2005

WATER RESOURCES DEPT.
SALEM, OREGON

FINAL PROOF SURVEY

UNDER

Application No. 17722 / 18605 Permit No. 13392 / 14246

IN NAME OF

Milton N. Simon

Surveyed Aug. 11, 1942, by Geo. W. Pederman

RECEIVED

APR 27 2005

WATER RESOURCES DEPT
SALEM, OREGON