


T1N, R4W, WM

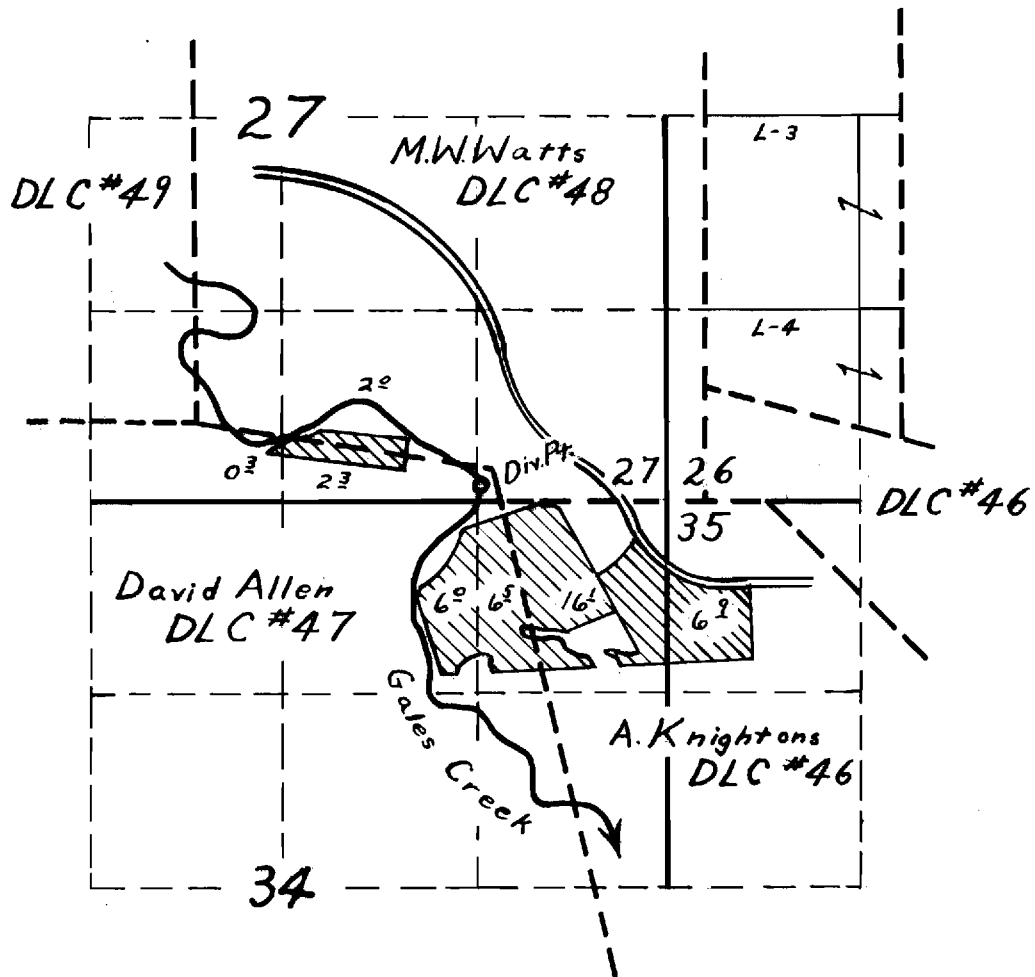

**FINAL PROOF SURVEY**

UNDER

Application No. 25098 Permit No. 19753

IN NAME OF

Milton N. Simon

Surveyed 4-11 1956, by R.D. Best