


# T.1N. R.4 W.W.M.

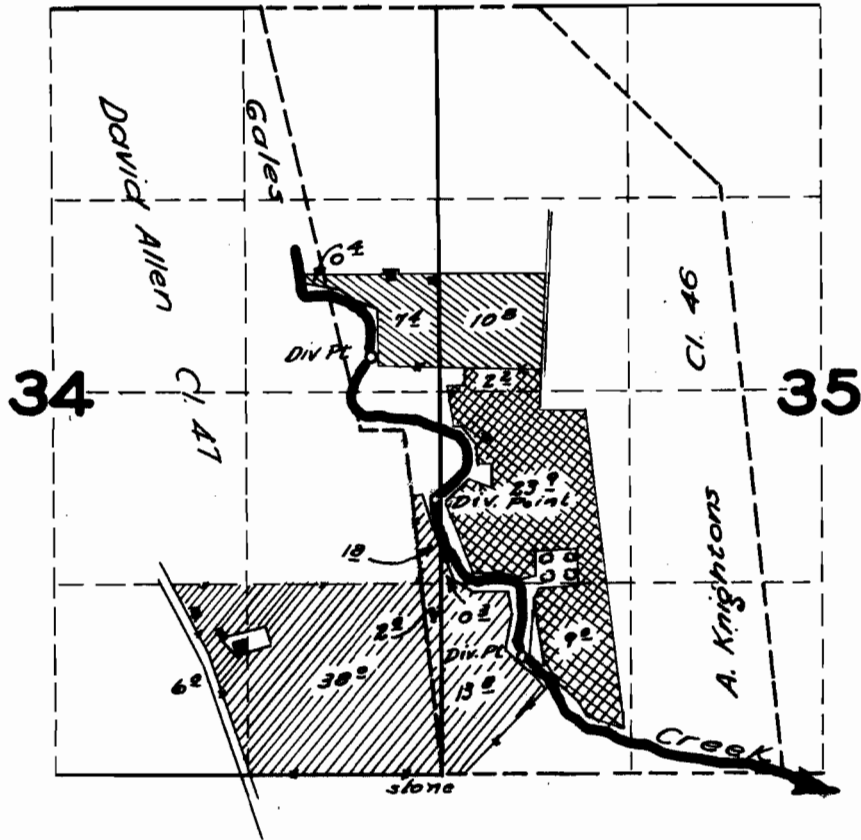

## FINAL PROOF SURVEY

UNDER

C. O. INGLES	APP. 23692	PER. 18714
E. F. SCHMID	APP. 24714	PER. 19496
C. J. SANDE	APP. 22816	PER. 17960



Surveyed 4 / 21 1952 by H. L. COFFMAN