


T. 1 N. R. 3 W. W.M.

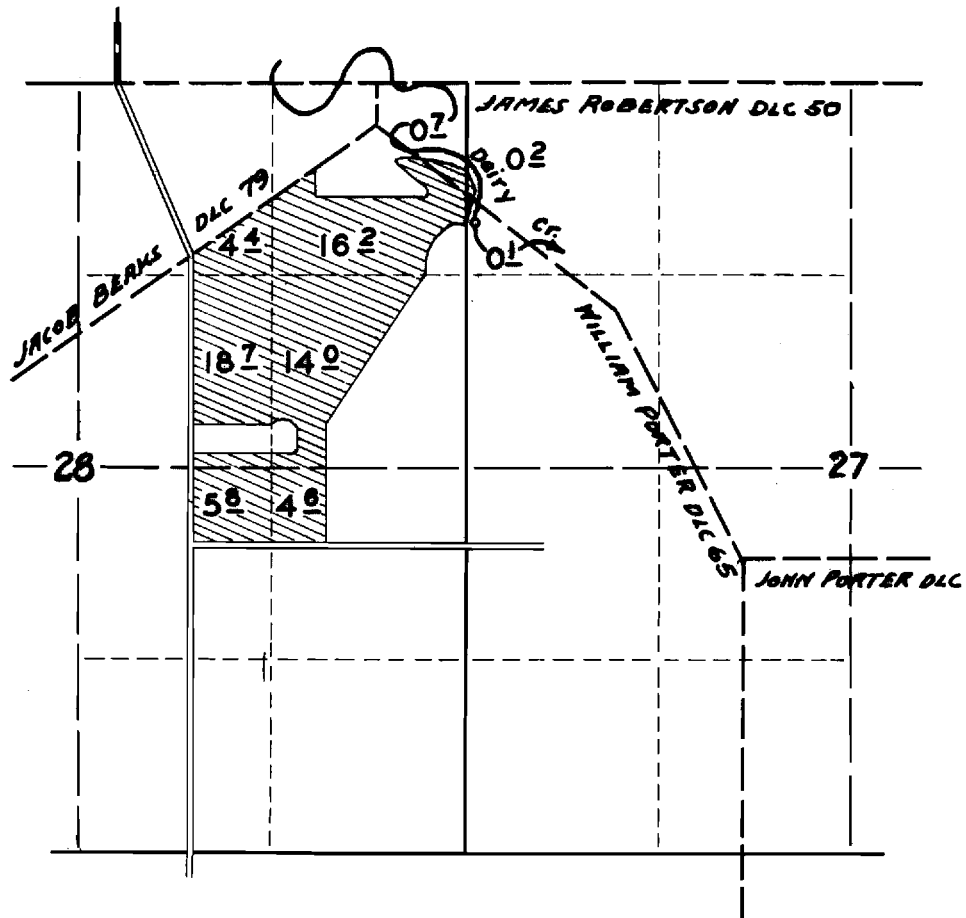

FINAL PROOF SURVEY

UNDER

Application No. 2662 | Permit No. 20846

IN NAME OF

CORNELIUS H. SUSBAUER

Surveyed 4 - 26 1956, by R.H. WHITBY