


T1N, R4W, WM.

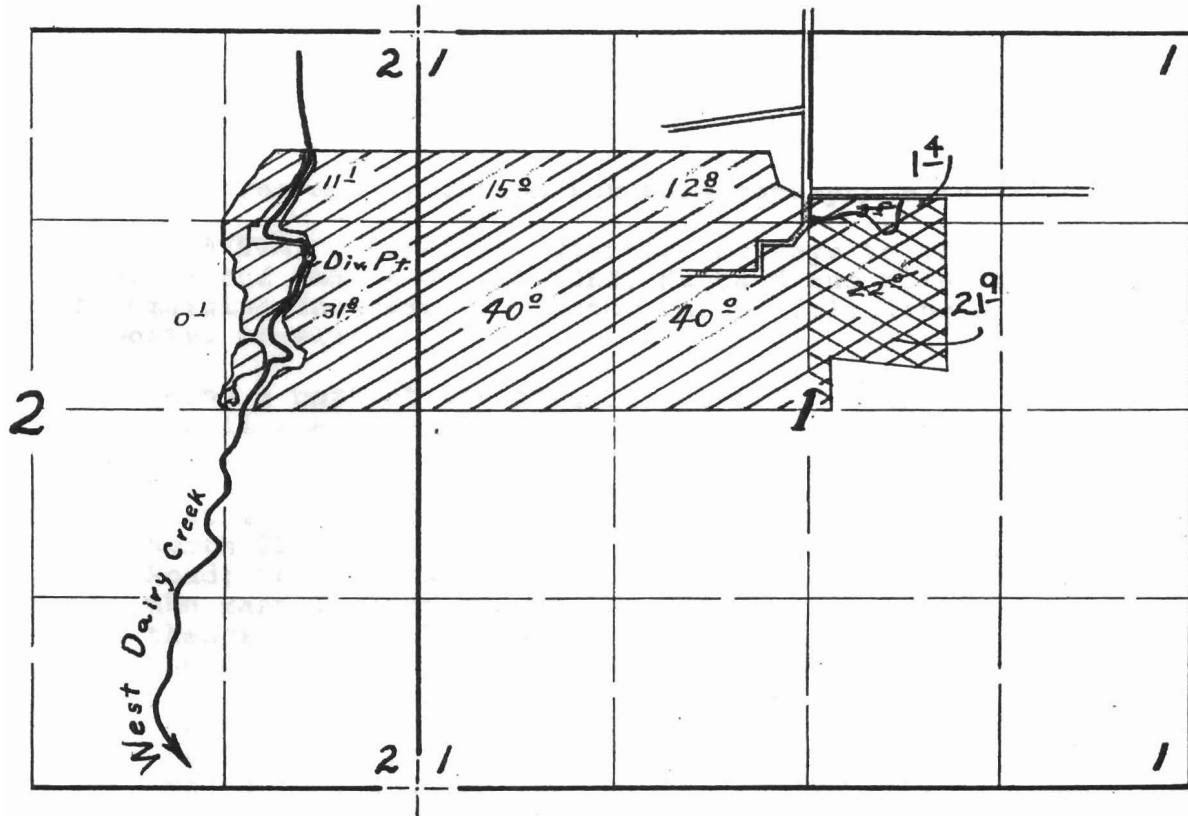

FINAL PROOF SURVEY
UNDER

Application No. 24367 Permit No. 1943
IN NAME OF

Ray Diericks

Surveyed 4-9 1956, by R.D. Best

RECEIVED
FFR 28 2005
WATER RESOURCES DEPT.
SALEM, OREGON

DFR-2D-195
DFR-3D-188

wc