


T. 1 S. R. 4 W. W. M.

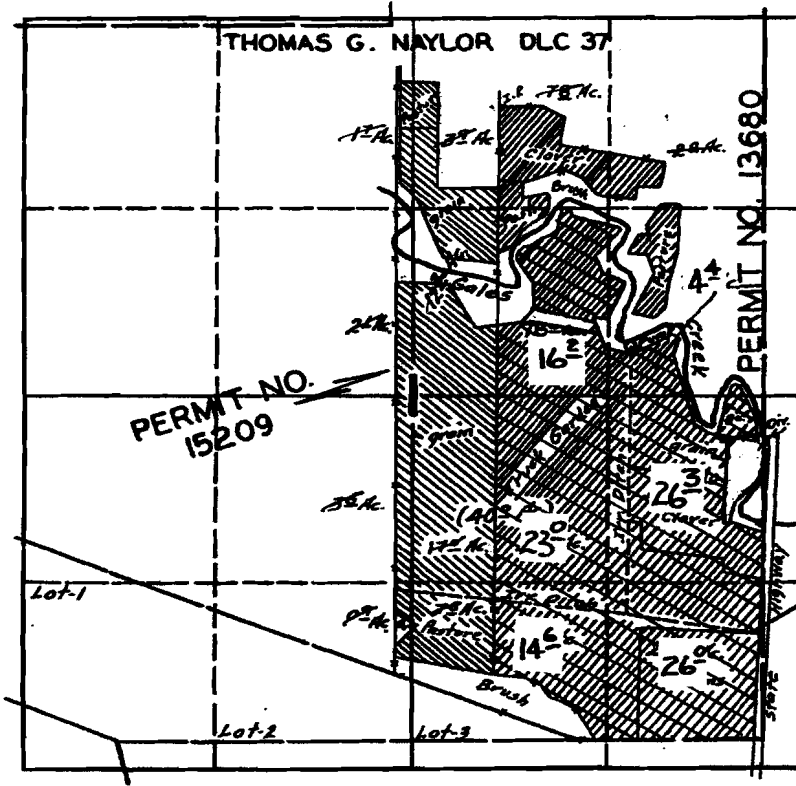

RECEIVED

FEB 28 2005

WATER RESOURCES DEPT.
SALEM, OREGON

FINAL PROOF SURVEY

UNDER

Application No. 18008 Permit No. 13680
Application No. 19636 Permit No. 15209

IN NAME OF

GEORGE L. HENDRICKS

Surveyed JULY 25 1944, by *[Signature]*