


T. 1 S., R. 4 W., W.M.

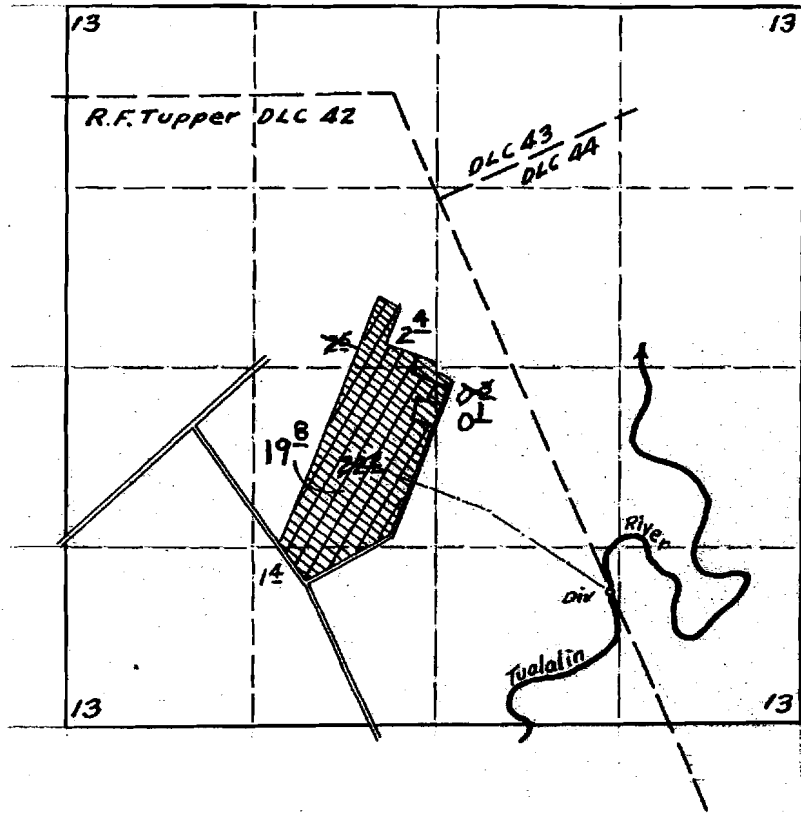

RECEIVED

FEB 28 2005  
WATER RESOURCES DEPT.  
SALEM, OREGON

**FINAL PROOF SURVEY**  
UNDER

Application No. 23774 Permit No. 18760  
IN NAME OF

Joseph L. Bridges

Surveyed 4-23 1956, by R. D. Best