


T.1N., R.4W., W.M.

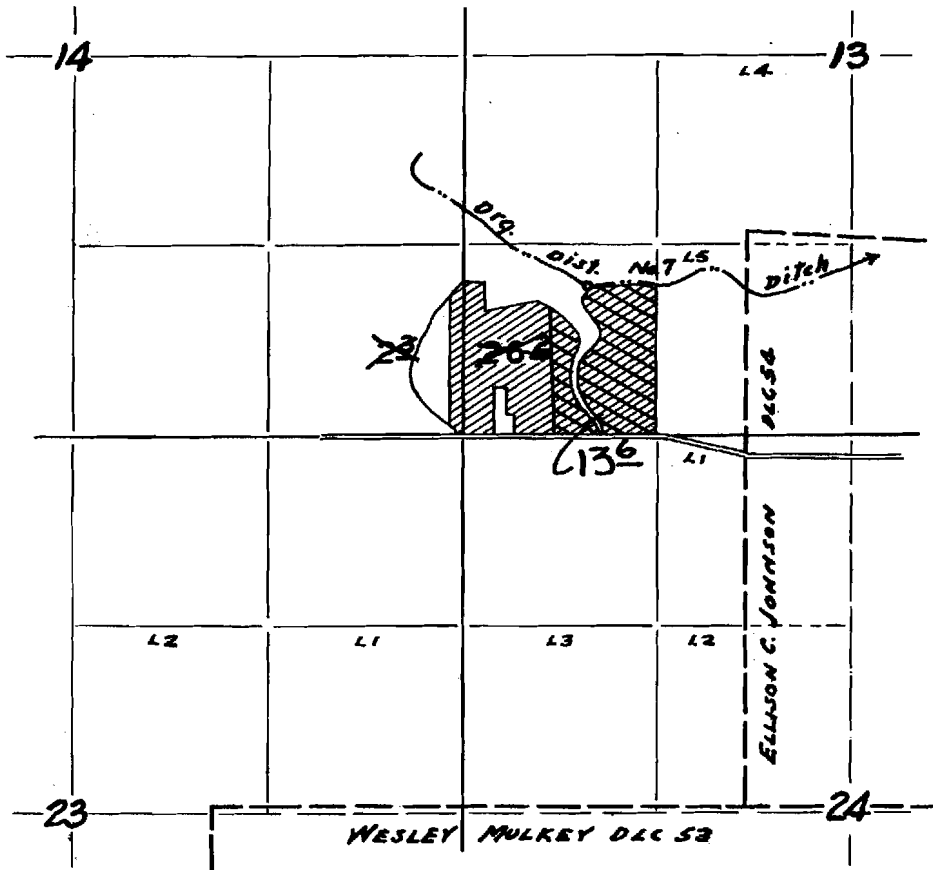

RECEIVED

FFR 28 2005

WATER RESOURCES DEPT.
SALEM, OREGON

FINAL PROOF SURVEY
UNDER

Application No. 26106 Permit No. 20576
IN NAME OF

FRED & ANNA MEURY

Surveyed 4 - 18 1956, by R.H. WHITBY

DFR-3D-186

WC