


T. 1 N. R. 3 W. W. M.

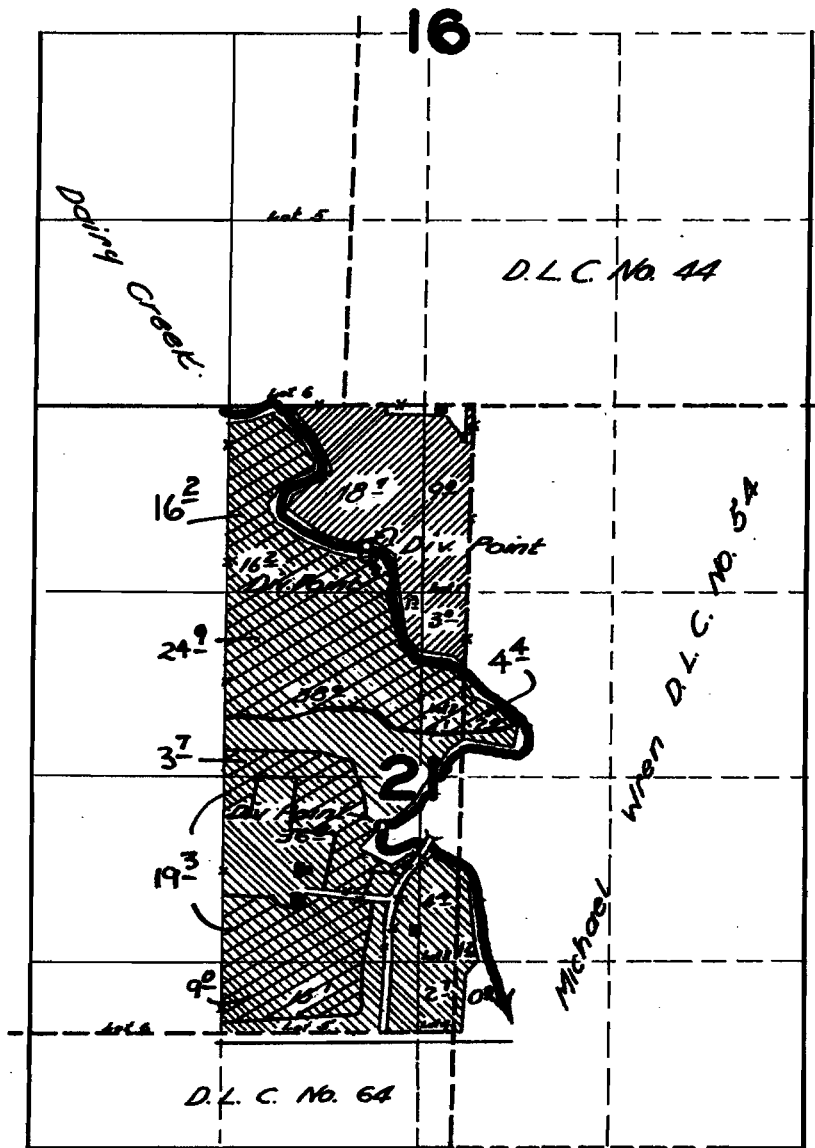


RECEIVED
FEB 28 2005
WATER RESOURCES DEPT.
SALEM, OREGON


FINAL PROOF SURVEY

UNDER

APPLICATION 20736 PERMIT 16211
APPLICATION 19489 PERMIT 15069

JOHN HERINCKX
ADDIE MARSH

APP. 20736 

APP. 19489 

Surveyed 8/2 1951, by H.L. COFFMAN