


T.1N., R.3W., W.M.

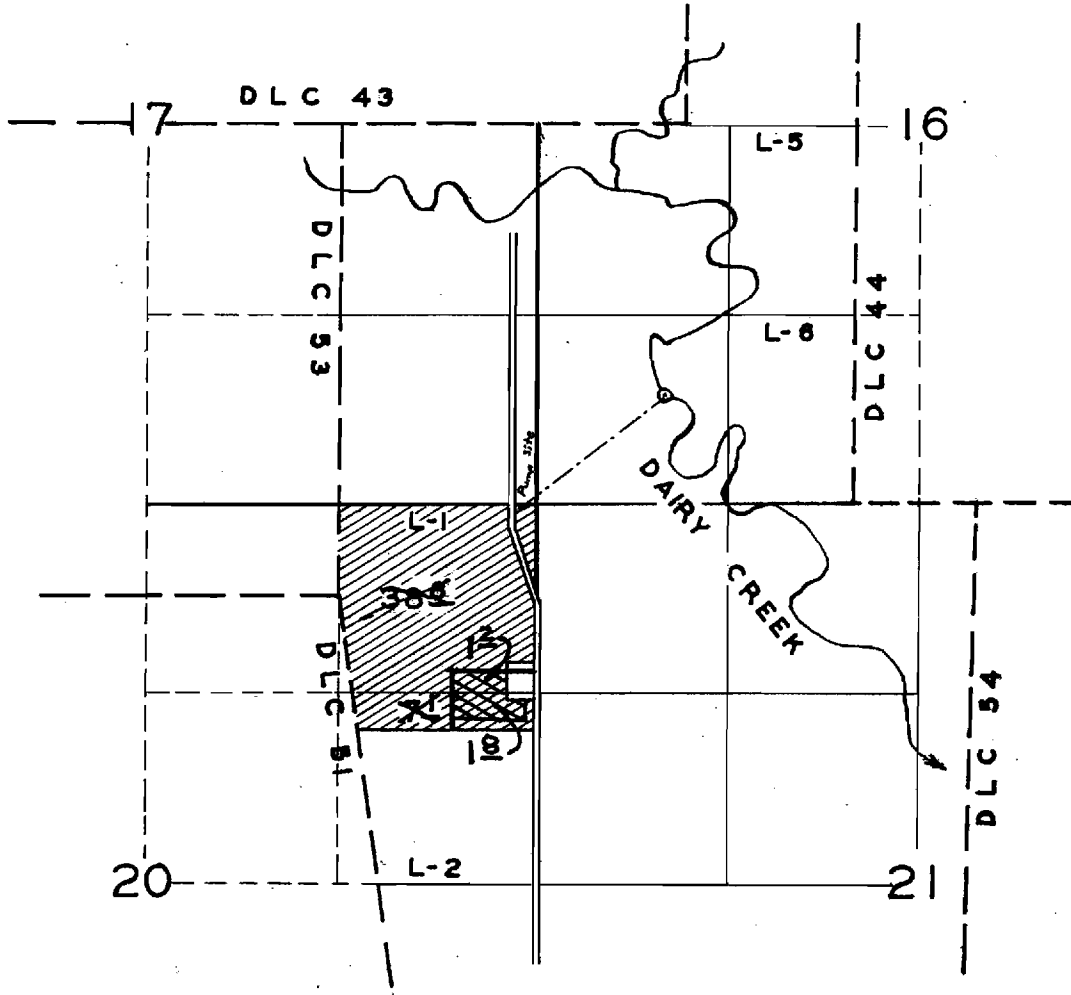

FINAL PROOF SURVEY

UNDER

Application No. 20140 Permit No. 15699

IN NAME OF

WILLIAM MARSH

Surveyed 4 - 17 19.56 by R.H. WHITBY.

RECEIVED


MAR 21 2005

WATER RESOURCES DEPT
SALEM, OREGON

DFR-5D-03

WC

T.1N., R.3W., W.M.

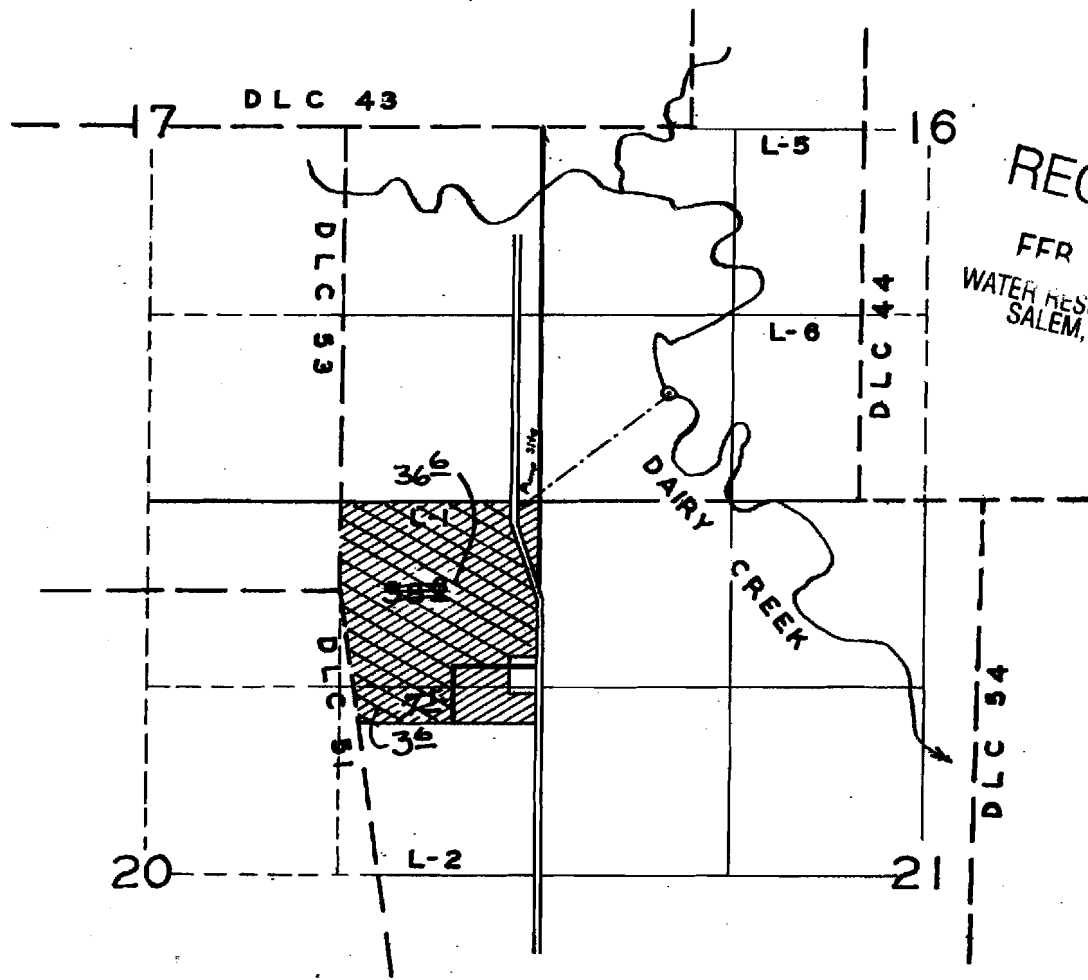

RECEIVED
FFR 28 2005
WATER RESOURCES DEPT.
SALEM, OREGON

FINAL PROOF SURVEY
UNDER

Application No. 20140 Permit No. 15699
IN NAME OF

WILLIAM MARSH

Surveyed 4-17 1956 by R.H. WHITBY