


T.1S.R.3W.W.M.

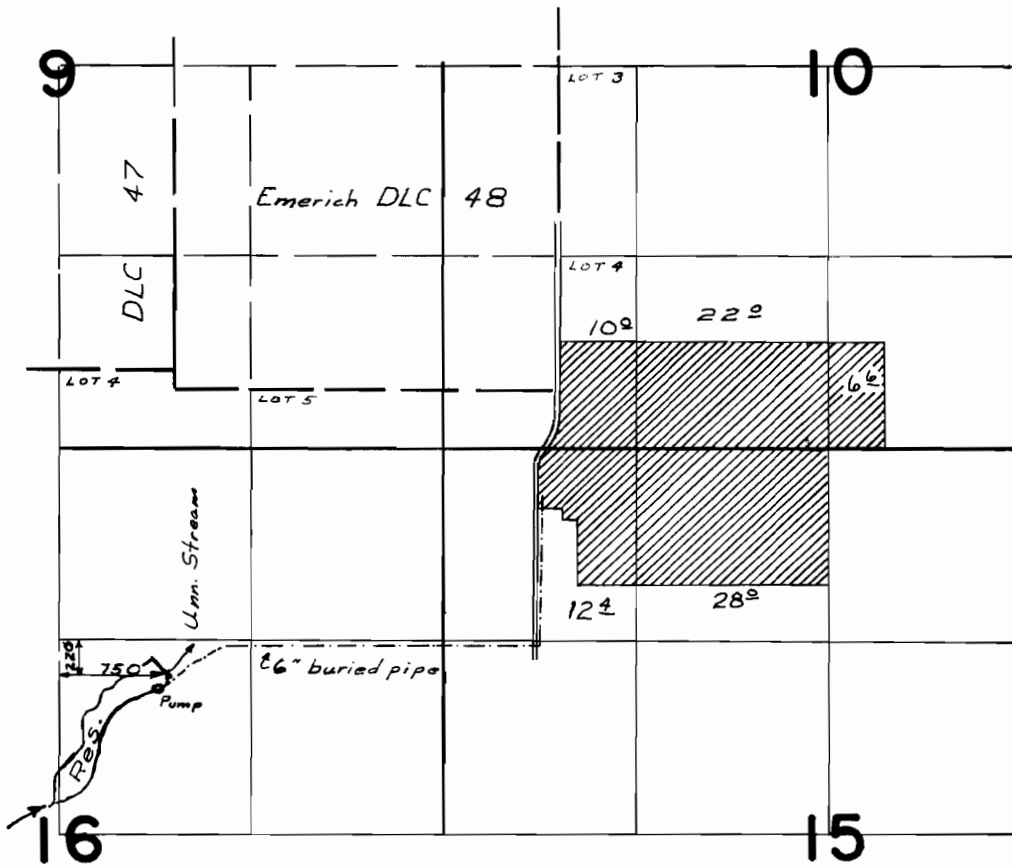

FINAL PROOF SURVEY UNDER

Application No. 34975 Permit No. 27429
IN NAME OF

Carlton Nursery Company

Surveyed Aug 16, 1967, by W.J. Ruppert