


11-27-1973

V23, P45

JOHN LOUISIGNOUT D.L.C. 52

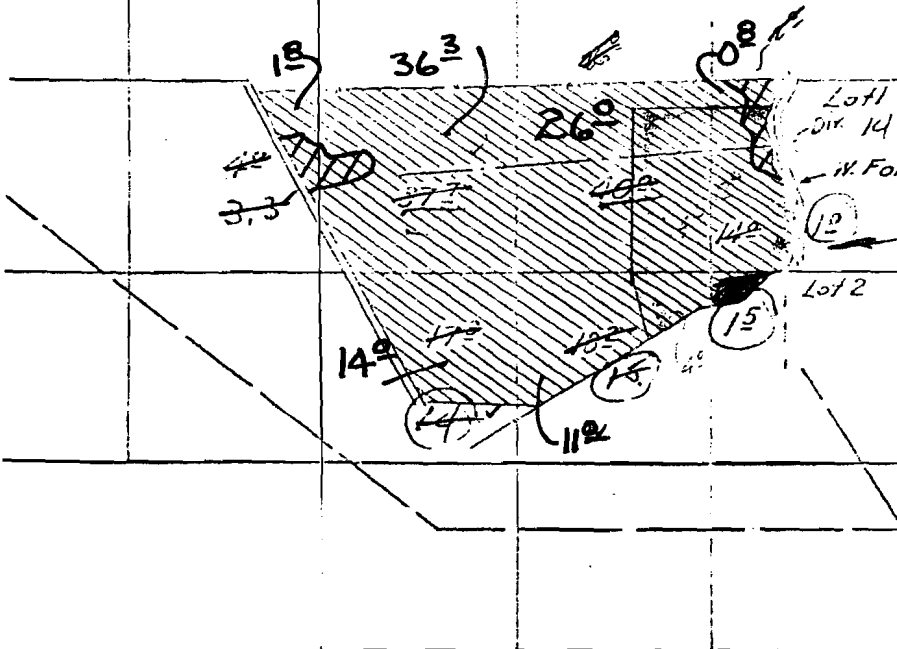

AREA IN BLUE IS AN ACCURATE  
 REPRESENTATION OF THE ACRES  
 LISTED ON THE TRANSFER  
 1-11-80

14

13

RECEIVED

FEB 28 2005  
 WATER RESOURCES DEPT.  
 SALEM, OREGON

Approved Aug 15, 1941  
John Louisignout

Acres 17702

Per. 13303