


T. 1 N. R. 4 W. W. M.

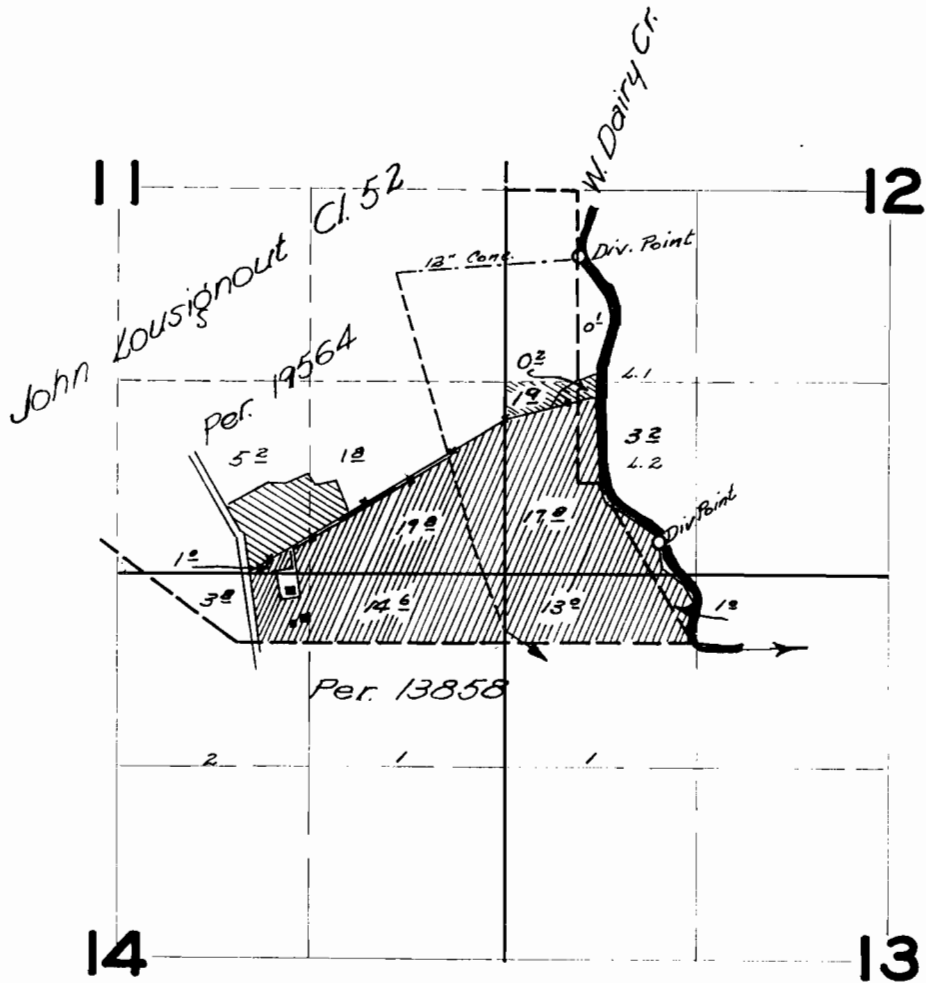

FINAL PROOF SURVEY

UNDER

24864

19564

Application No. 18264

Permit No. 13858

IN NAME OF

L. J. HEESACKER

HENRY AND GERTRUDE LANDAUER

Surveyed 4 / 23 19 52, by H. L. COFFMAN