


T.1N., R.4W., W.M.

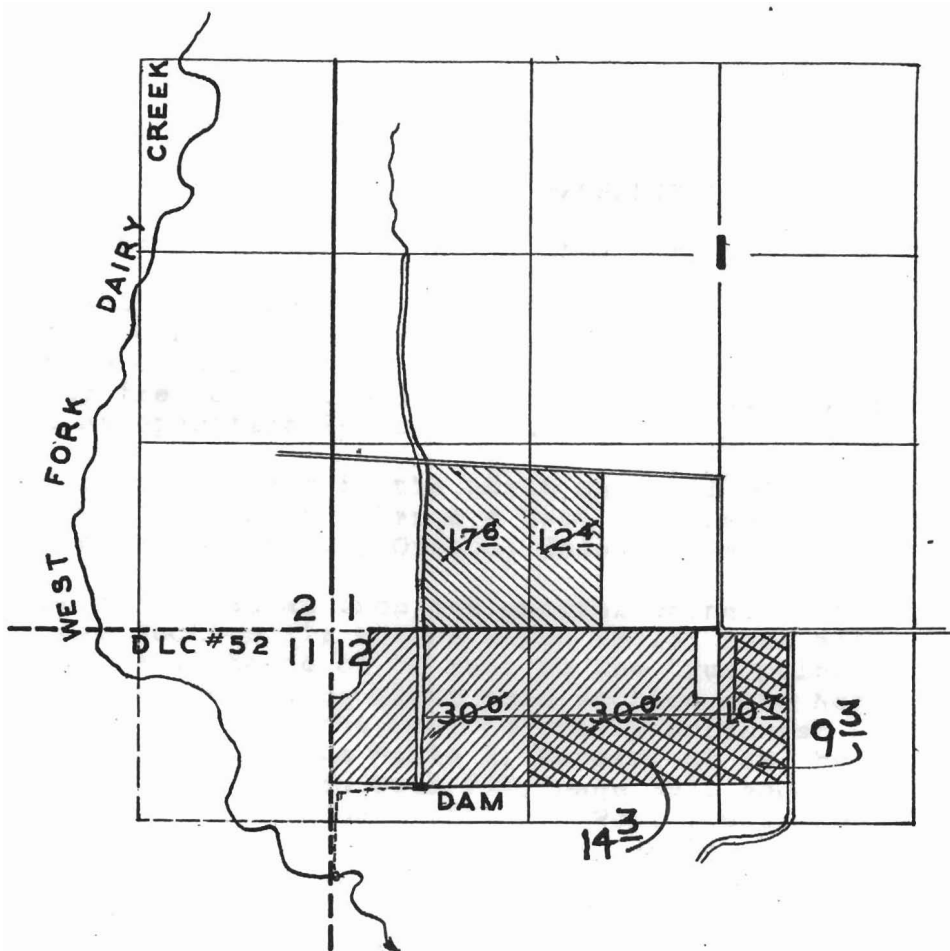

RECEIVED
FFR 7 8 2005
WATER RESOURCES DEPT.
SALEM, OREGON

FINAL PROOF SURVEY

R-25488 UNDER

R-1302

25489

20969


Application No. 25490 Permit No. 20970

IN NAME OF

GERALD J. & ANTHONY P. HERB

Surveyed 4 - 13 1956, by R.H. WHITBY.

T.1N., R.4W., W.M.

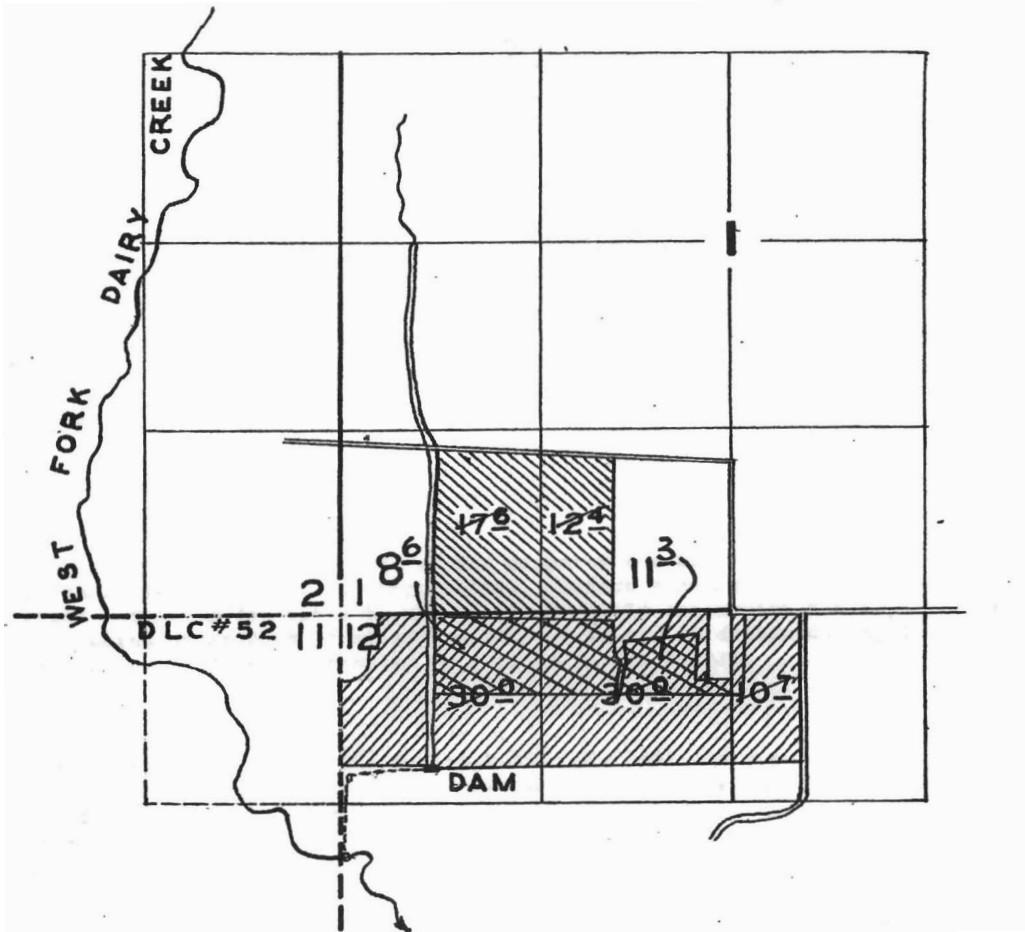

FINAL PROOF SURVEY

R-25488 UNDER

R-1302

25489

20969

Application No. 25490 Permit No. 20970

IN NAME OF

GERALD J. & ANTHONY P. HERB

Surveyed 4-13 1956, by R.H. WHITBY.

RECEIVED

MAR 21 2005

WATER RESOURCES DEPT
SALEM, OREGON