


T.1N.R.3W.W.M.

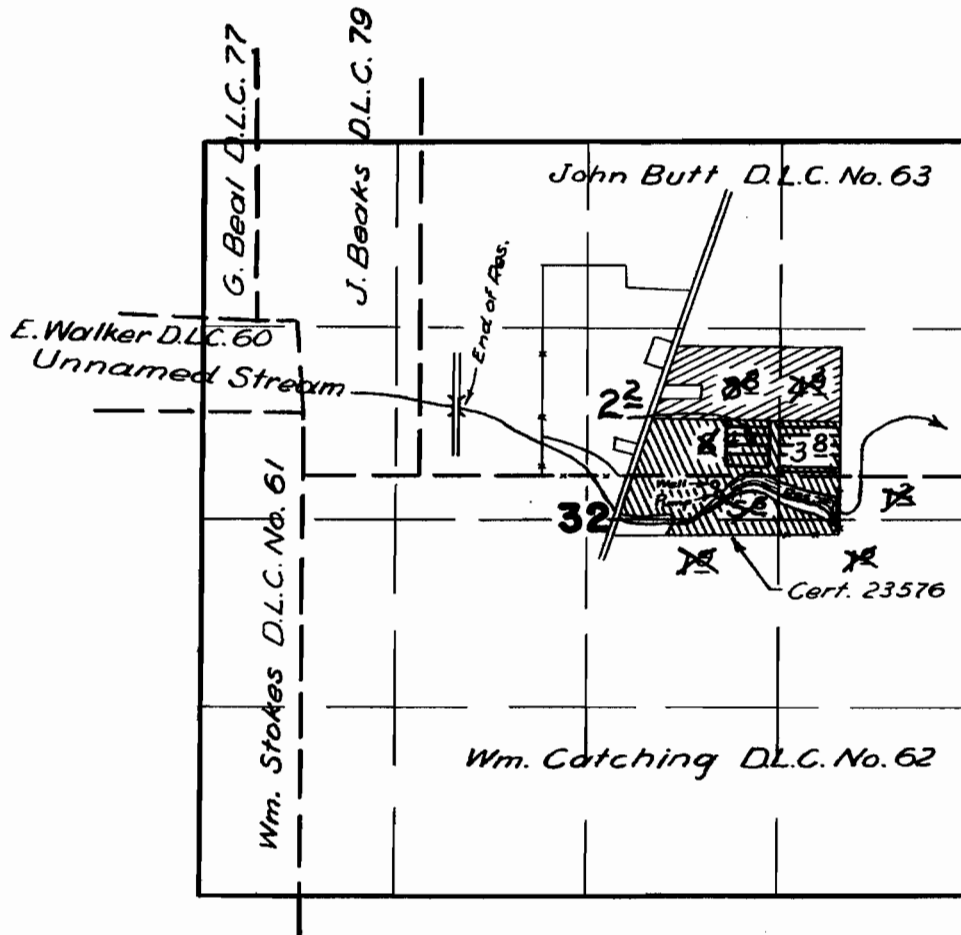

FINAL PROOF SURVEY UNDER

Application No. R-33241 33242 Permit No. R-2285 26402
IN NAME OF

HERBERT B. SANNOV

Surveyed MAP 27 May 24 1963, by M. B. Biech

RECEIVED

FFR 28 2005
WATER RESOURCES DEPT.
SALEM, OREGON

RECEIVED

APR 18 2005

WATER RESOURCES DEPT.
SALEM, OREGON