


# T.I.N.R.3W.W.M.

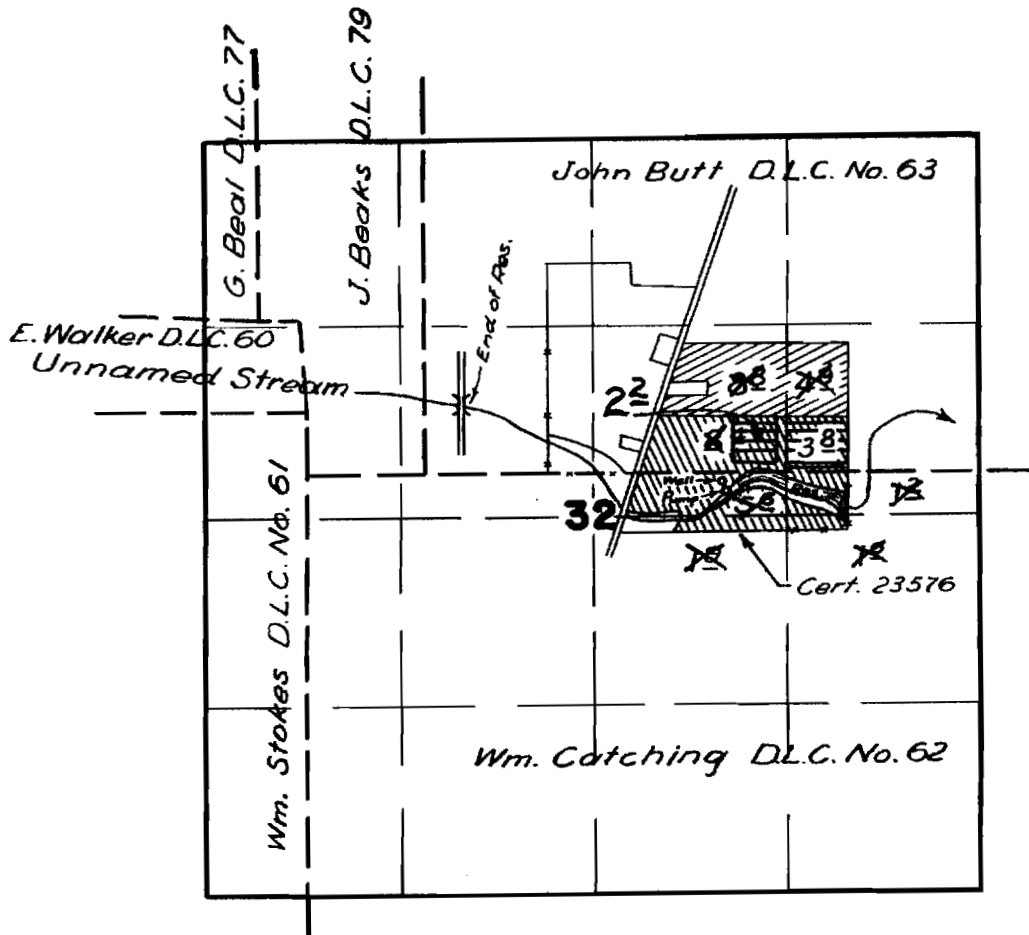

## FINAL PROOF SURVEY UNDER

Application No. R-33241 33242 Permit No. R-2285 26402  
IN NAME OF

HERBERT B. SAHNOV

Surveyed Mar 27 May 24 1963, by M. B. [Signature]

RECEIVED

FFR 28 2005  
WATER RESOURCES DEPT.  
SALEM, OREGON

RECEIVED

APR 18 2005

WATER RESOURCES DEPT.  
SALEM, OREGON