



T.1N.,R.3W.,W.M. SECTION 18

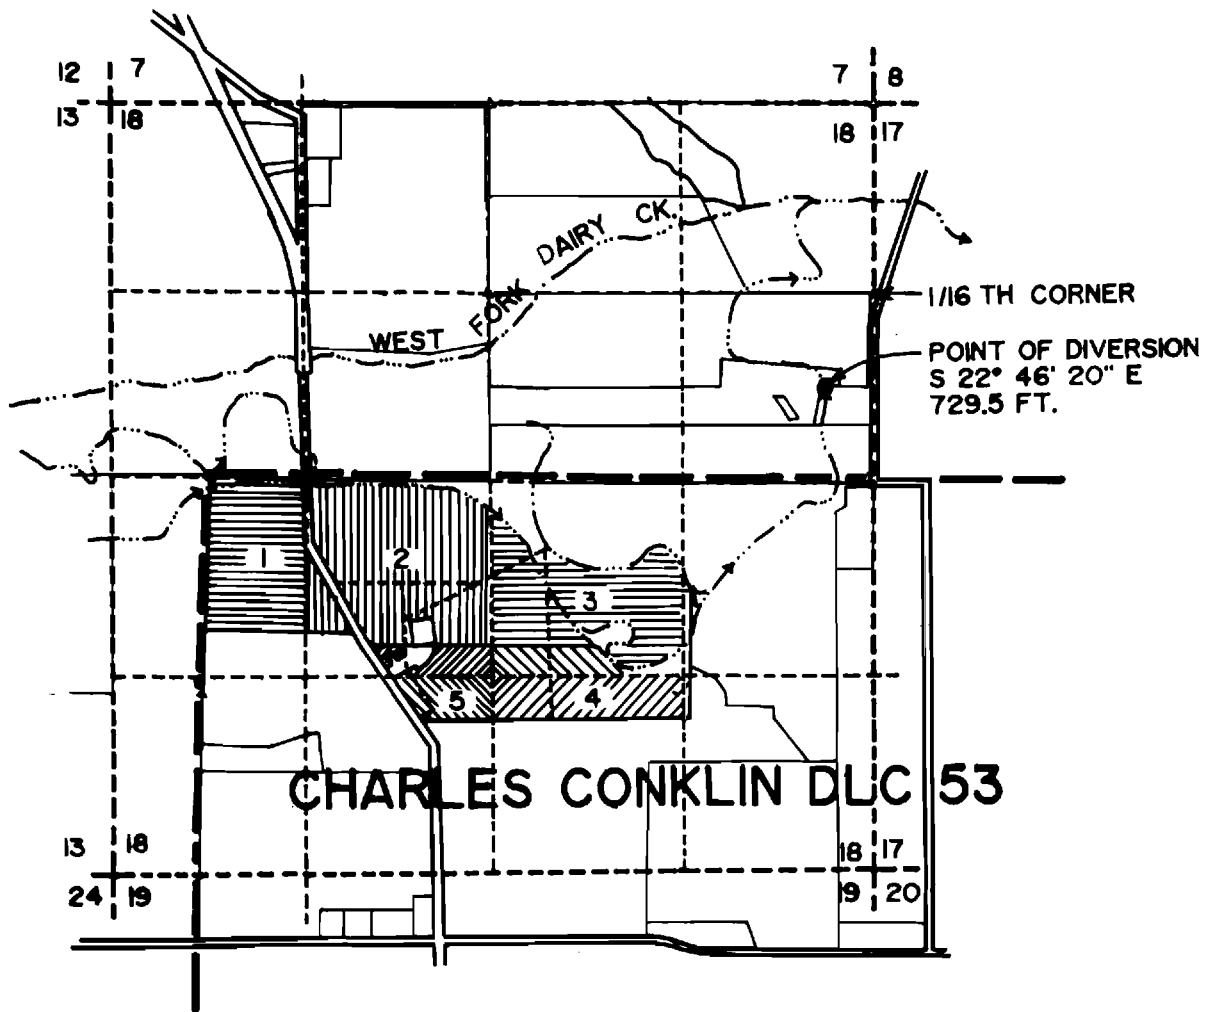

CHARLES CONKLIN DLC 53

SCALE 1" = 1320'

FINAL PROOF SURVEY UNDER

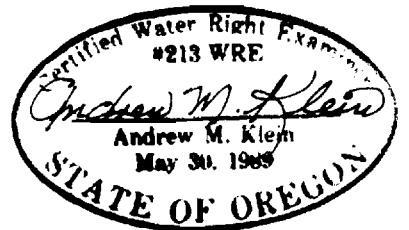

Transfer 6302

IN NAME OF
EUGENE EVERS

THIS MAP IS FOR THE PURPOSE OF IDENTIFYING THE LOCATION OF THE WATER RIGHT ONLY AND IS NOT INTENDED TO PROVIDE LEGAL DIMENSIONS OR THE LOCATION OF PROPERTY OWNERSHIP LINES.

Surveyed SEPT. 18, 1992, by A. M. KLEIN

- 1 NW 1/4 SW 1/4
15.0 ACRES
(CERT. 14464)
- 2 NE 1/4 SW 1/4
33.0 ACRES
(CERT. 14464)
3.0 ACRES
(CERT. 39603)
- 3 NW 1/4 SE 1/4
17.0 ACRES
(CERT. 14464)
2.3 ACRES
(CERT. 39603)
- 4 SW 1/4 SE 1/4
12.2 ACRES
(CERT. 39603)
- 5 SE 1/4 SW 1/4
6.2 ACRES
(CERT. 39603)