


T. 1N. R. 3W. W.M.

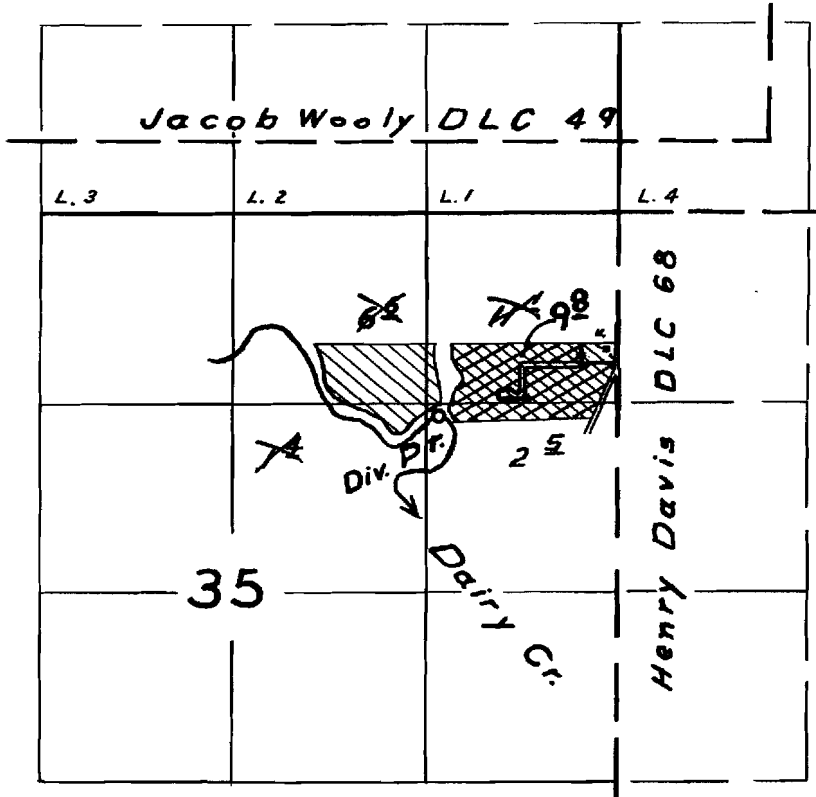

RECEIVED

FFR 7 8 2005

WATER RESOURCES DEPT.  
SALEM, OREGON

**FINAL PROOF SURVEY**  
UNDER

Application No. 28179 Permit No. 22174  
IN NAME OF

Raleigh D. Cavens

Surveyed April 28 1958 by R. H. Whitby