


T. 1S. R. 3W. W. M.

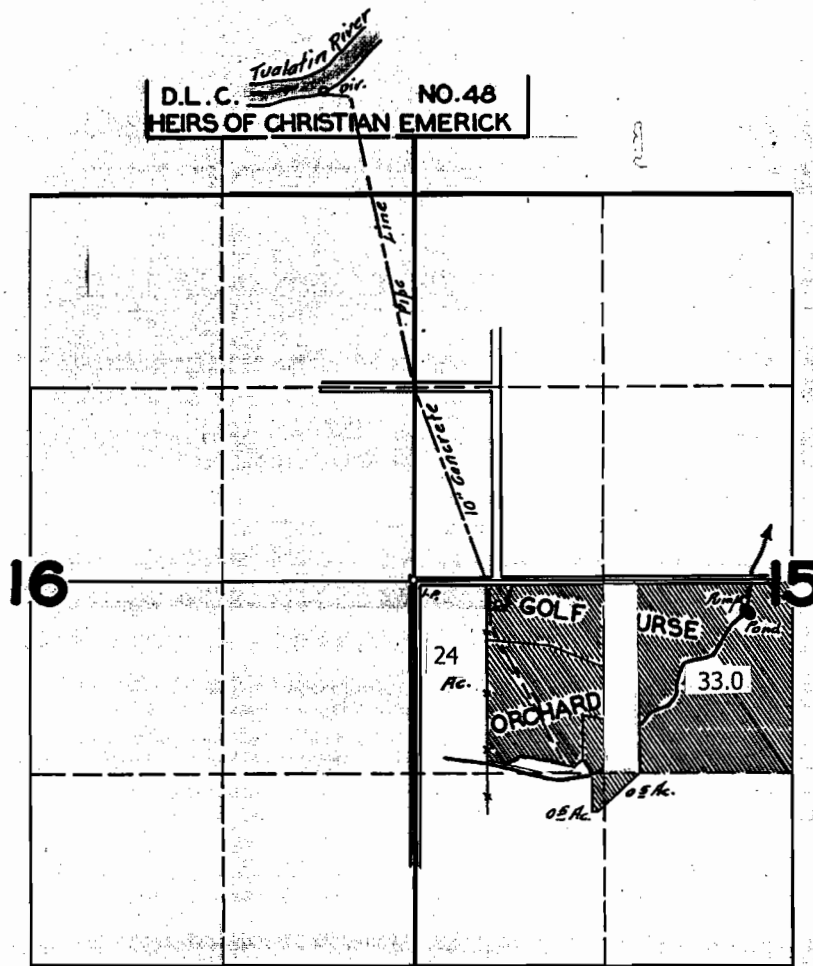

RECEIVED

APR 18 2005

WATER RESOURCES DEPT
SALEM, OREGON

FINAL PROOF SURVEY UNDER

Application No. 18117 Permit No. 13770

IN NAME OF

WILLIAM M. MARTIN, PROP. - FOREST HILLS GOLF COURSE.

Surveyed SEP. 12 1946 by *[Signature]*