


T. 1 S. R. 3 W. W.M.

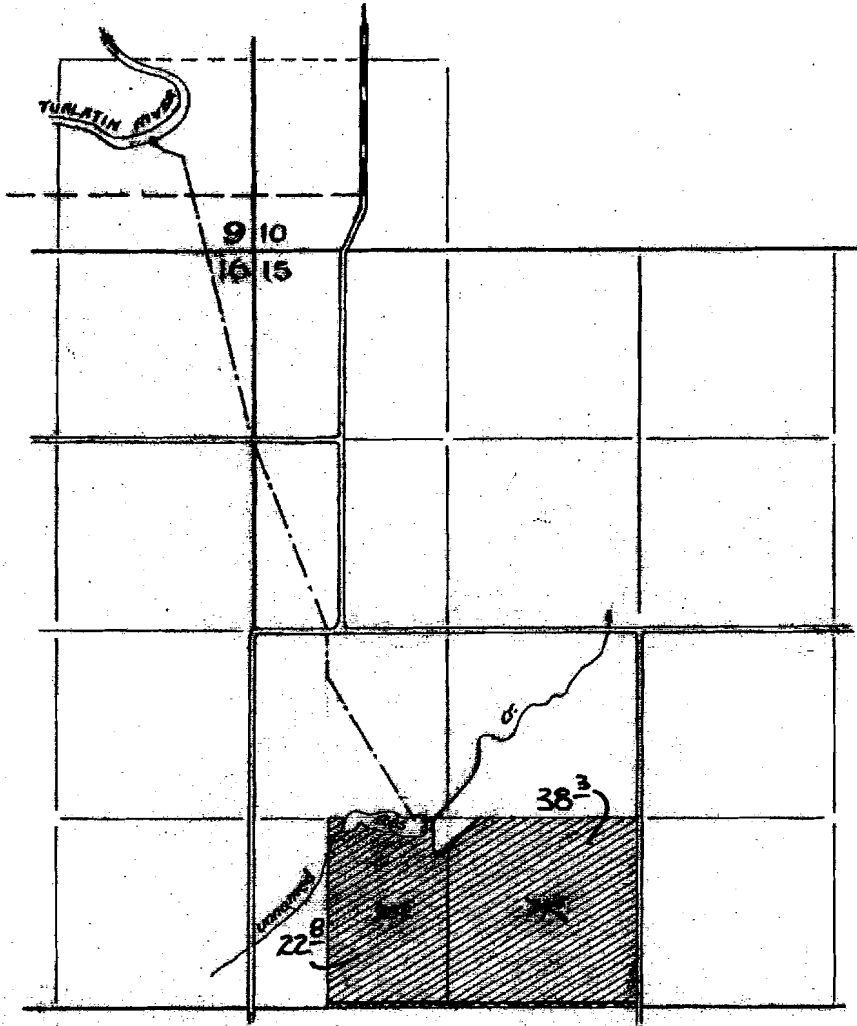

RECEIVED

FFR 28 2005

WATER RESOURCES DEPT.
SALEM, OREGON

FINAL PROOF SURVEY

UNDER

R-27380

R-1389

Application No. 27337 Permit No. 21527

IN NAME OF

WILLIAM M. MARTIN

Surveyed 4-30 1956 by R.H. WHITBY

DFR-2D-165

WC