
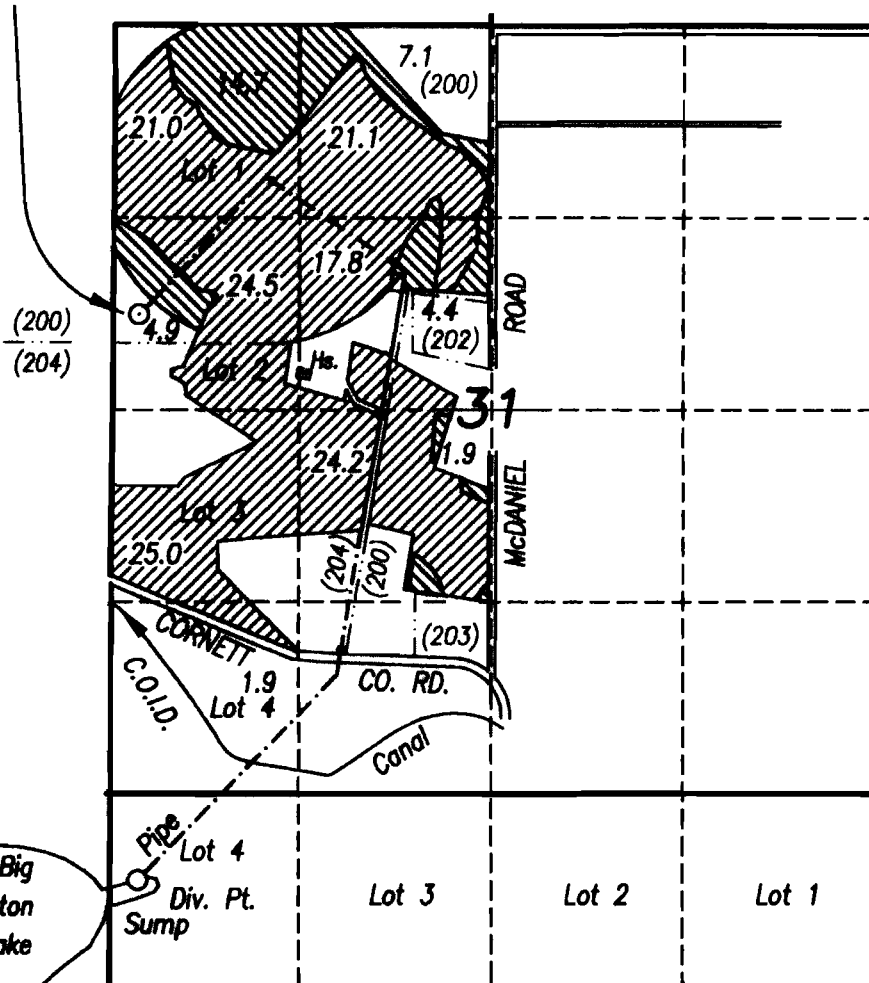


612764
T9678
81065
81282


T.14S., R.15E., W.M. CROOK COUNTY

G13762
WELL IS LOCATED
S. 1990' & E. 180'
FROM NW CORNER
SECTION 31

SCALE: 1" = 1320'

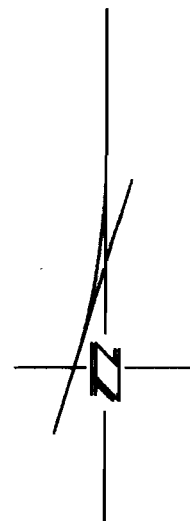

- EXISTING RIGHTS
- WATER RIGHTS ON
- MAINLINE
- VALVE
- TAX LOT (202)

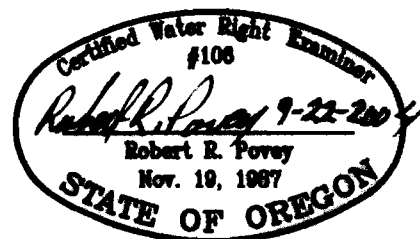

FINAL PROOF FOR GROUND WATER

Application No. G-13762 Permit No. G-12764
IN NAME OF

MOUNTAIN VIEW RANCH

RECEIVED

SEP 29 2004

WATER RESOURCES DEPT
SALEM, OREGON

I, Robert R. Povey, Oregon Certified Water Right Examiner #106, hereby certify the above Final Proof map was prepared under my direct supervision on September 26, 2000.

The preparation of this map is for the purpose of identifying the location of the water right only and has no intent to provide dimensions or locations of property ownership lines.

W/R G-13762	
NE1/4 NW1/4	28.2 AC.
GOV. LOT 1	35.7 AC.
GOV. LOT 2	29.4 AC.
SE1/4 NW1/4	22.2 AC.
NE1/4 SW1/4	26.1 AC.
GOV. LOT 3	25.0 AC.
GOV. LOT 4	1.9 AC.
SE1/4 SW1/4	---0---
TOTAL	168.5 AC.