



T. 8S., R. 39E., W. M.

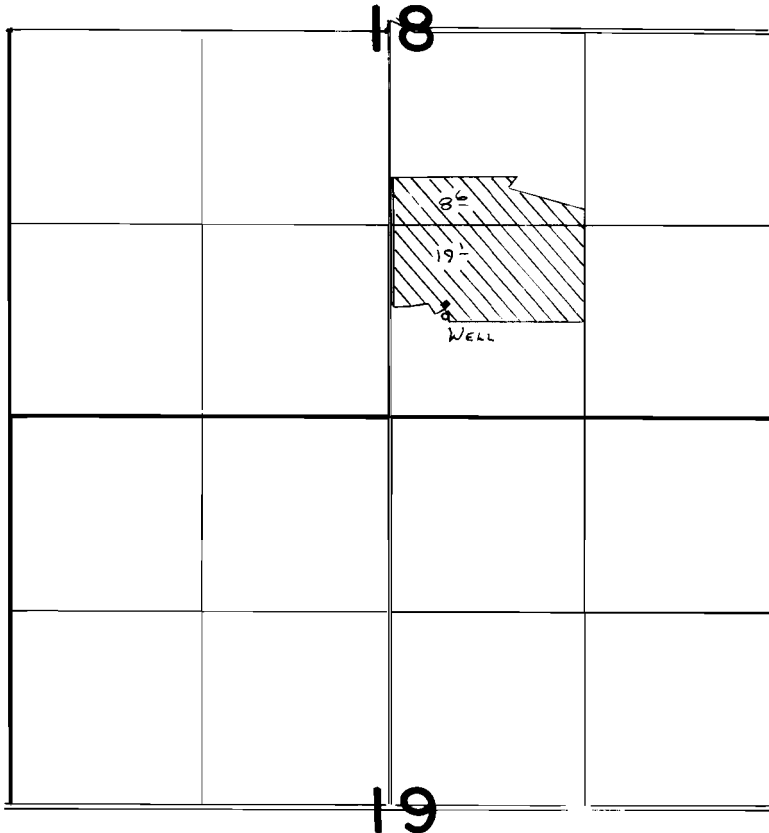

WELL LOCATED 690' N. & 350' E. FROM S¹/₄ COR. SECTION 18

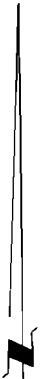

SCALE 1" = 1320'

FINAL PROOF SURVEY

UNDER

Application No. **G:7580** Permit No. **G:7090**
IN NAME OF

.....**GORDON B. PAUSTIAN**.....

Surveyed *May 24* 19*84*, by *L. L. Church*.....