


CLAIM OF BENEFICIAL USE MAP

UNDER APPLICATION R-81116; PERMIT R-13725

NW1/4 SE1/4 SEC 33 T 21S R 39E W.M.

U.S.G.S. QUAD - MONUMENT PEAK, OREG. - 7 1/2'

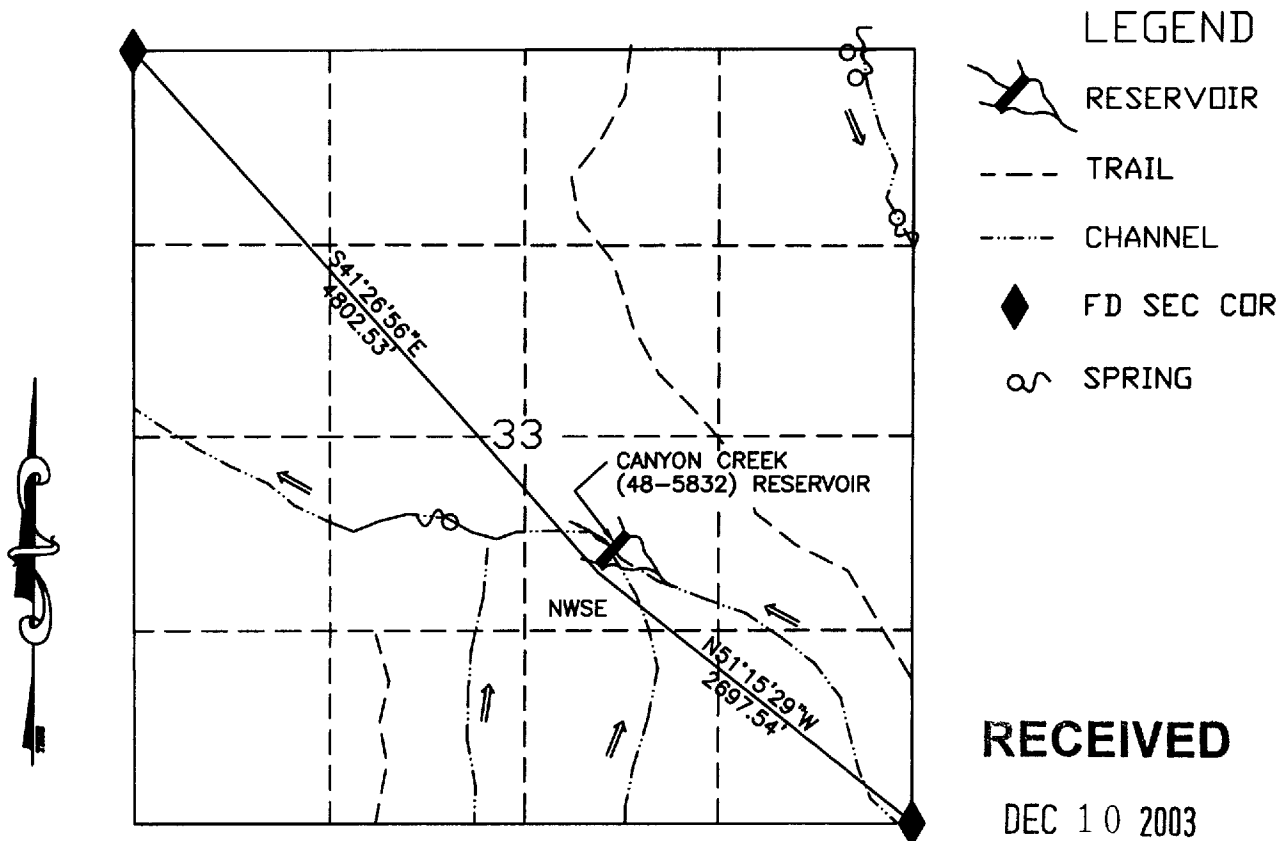

RECEIVED

DEC 10 2003

WATER RESOURCES DEPT
SALEM, OREGON

CANYON CREEK (48-5832) RESERVOIR

1320 660 0 1320
SCALE 1"=1320'

I, Thomas D. Terry, ADM Division of Field Support agree to the findings of the CWRE and do submit this site report and map as my Claim of Beneficial Use of the water as provided under the terms and conditions of my Permit R-13725

Thomas D. Terry



THIS MAP IS FOR THE PURPOSE OF LOCATING A WATER RIGHT AND IS NOT INTENDED TO PROVIDE LEGAL DIMENSIONS FOR LOCATION OF PROPERTY BOUNDARIES.

ACAD20001
DWG FILE: CANYONBENE

UNITED STATES DEPARTMENT OF THE INTERIOR BUREAU OF LAND MANAGEMENT DIVISION OF OPERATIONS VALE DISTRICT	
CANYON CREEK (48-5832) RESERVOIR	
DESIGNED:	
REVIEWED:	<i>Logan Hall</i>
APPROVED:	<i>Thomas D. Terry</i> ADM OPERATIONS AND FIELD SERVICES
DRAWN: CG	SCALE: 1"=1320'
DATE: 8/28/03	SHEET 1 OF 1
DRAWING NO. OR-03-9172.45-1199	