


T. I. N.

R. A. W.

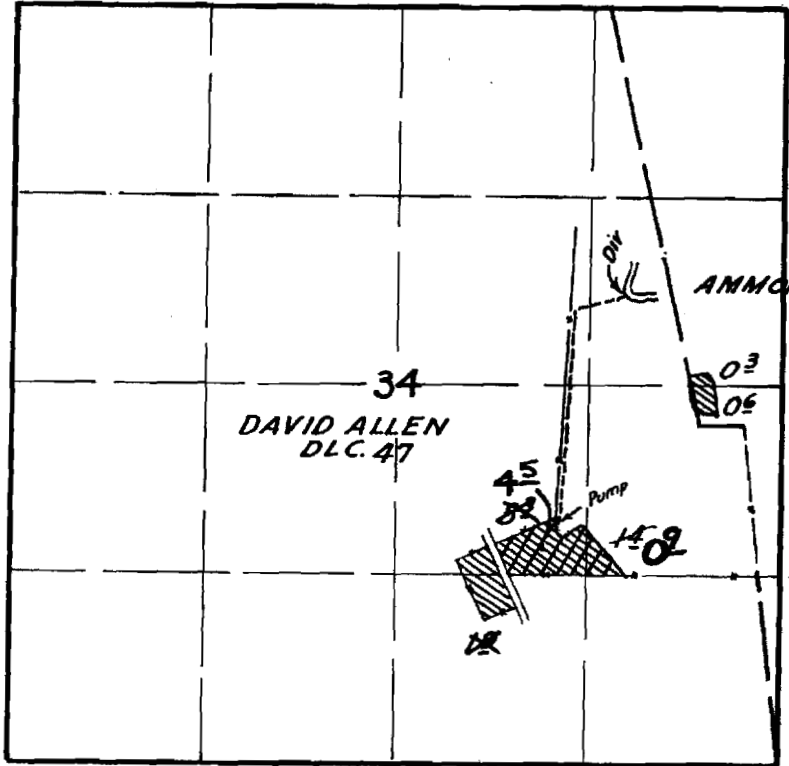

RECEIVED

MAR 07 2005

WATER RESOURCES DEPT
SALEM, OREGON

Surveyed Aug. 14, 1941
Charles A. Burnham

App. 18/95

Per. 13821