


T. 1 N. R. 3 W. W. M.

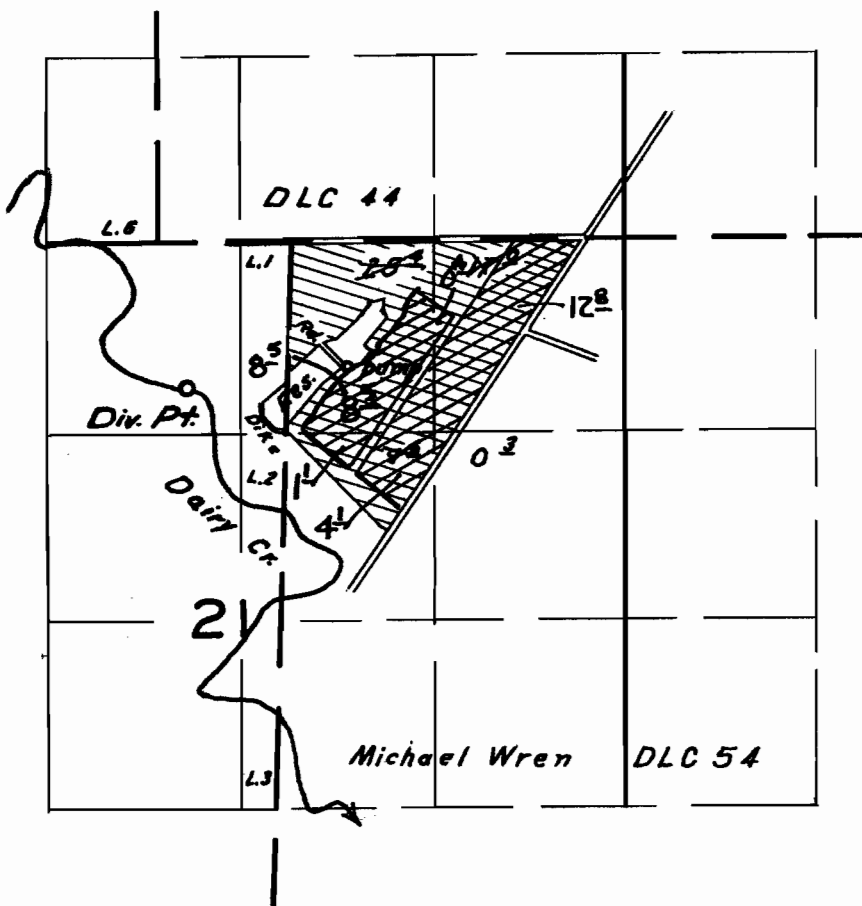

FINAL PROOF SURVEY UNDER

Application No. R-31280 Permit No. R-1994
31281 IN NAME OF 24772

John Herinckx

Surveyed April 30, 1958, by R.H. Whitby

RECEIVED

MAR 07 2005

WATER RESOURCES DEPT
SALEM, OREGON

RECEIVED

APR 18 2005

WATER RESOURCES DEPT
SALEM, OREGON