


T.1N.R.3 W.W.M.

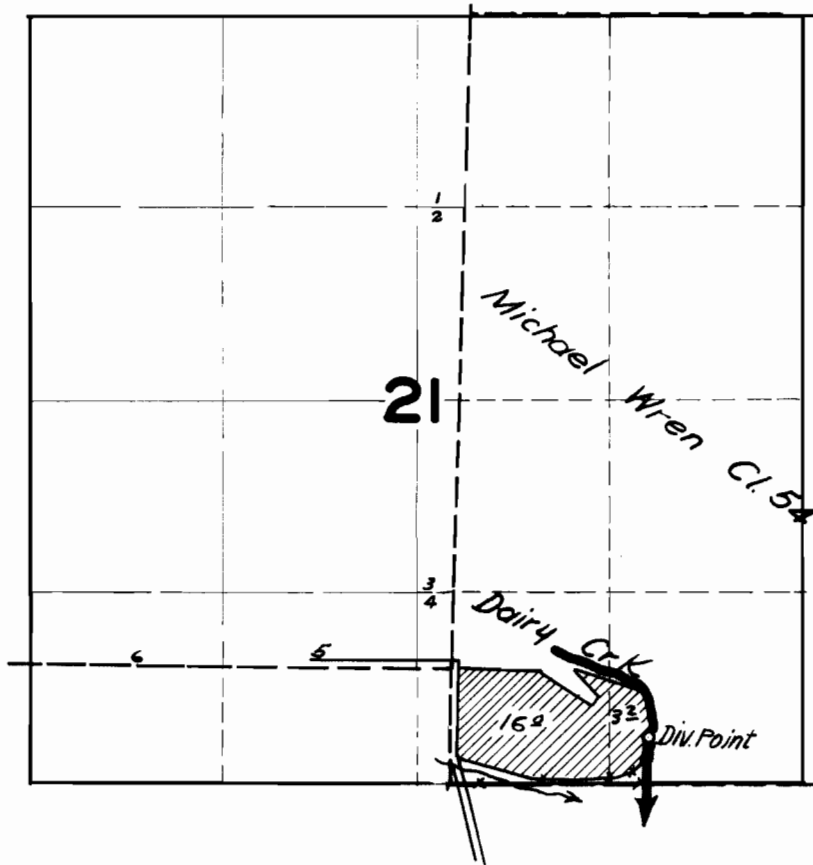

FINAL PROOF SURVEY

UNDER

Application No. 23207 Permit No. 18299

IN NAME OF

ANNA REH

Surveyed June 6, 1952, by H. L. COFFMAN