


T. 1 N., R. 3 W., W.M.

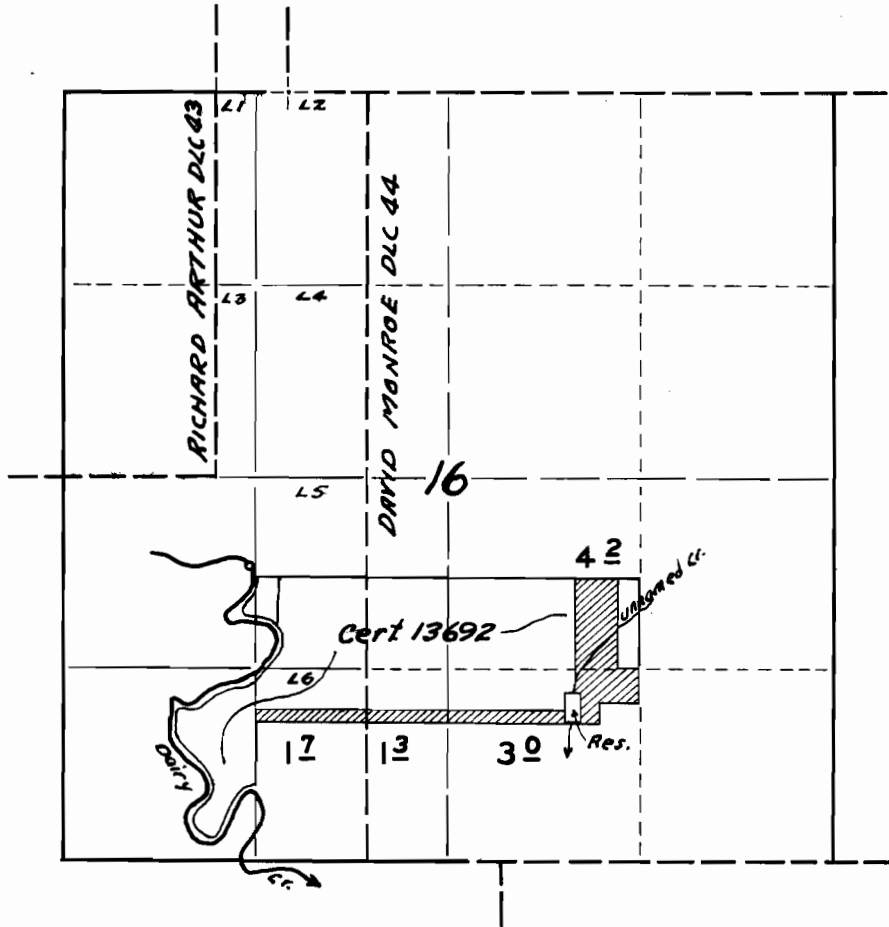

FINAL PROOF SURVEY

UNDER

R-27279

R-1358

Application No. 25603 Permit No. 21235

IN NAME OF

CECIL HEYNDERICKX

Surveyed 4-16-1956 by R.H. WHITBY.