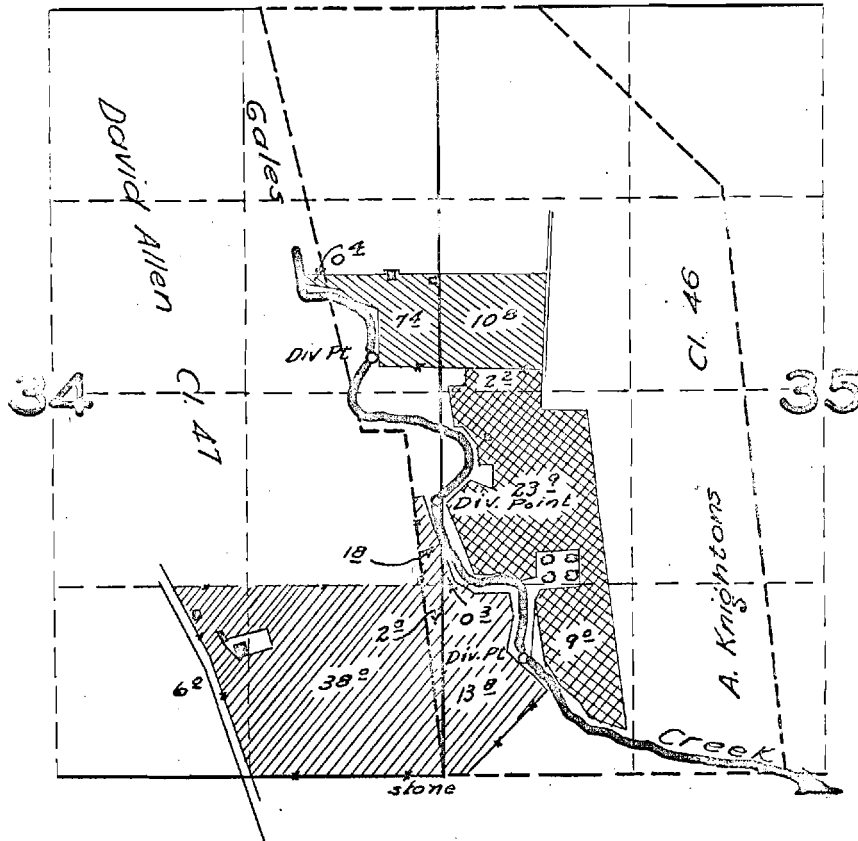

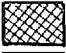



# T.1N.R.4W.M.



## FINAL PROOF SURVEY

UNDER

C. O. INGLES	APP. 23692	PER. 18714	
E. F. SCHMID	APP. 24714	PER. 19496	
C. J. SANDE	APP. 22816	PER. 17960	

Surveyed 4 / 21 1952, by H. L. COFFMAN

1952 A