


RECEIVED

T.1N.R.4W.W.M.

MAR 07 2005

WATER RESOURCES DEPT  
SALEM, OREGON

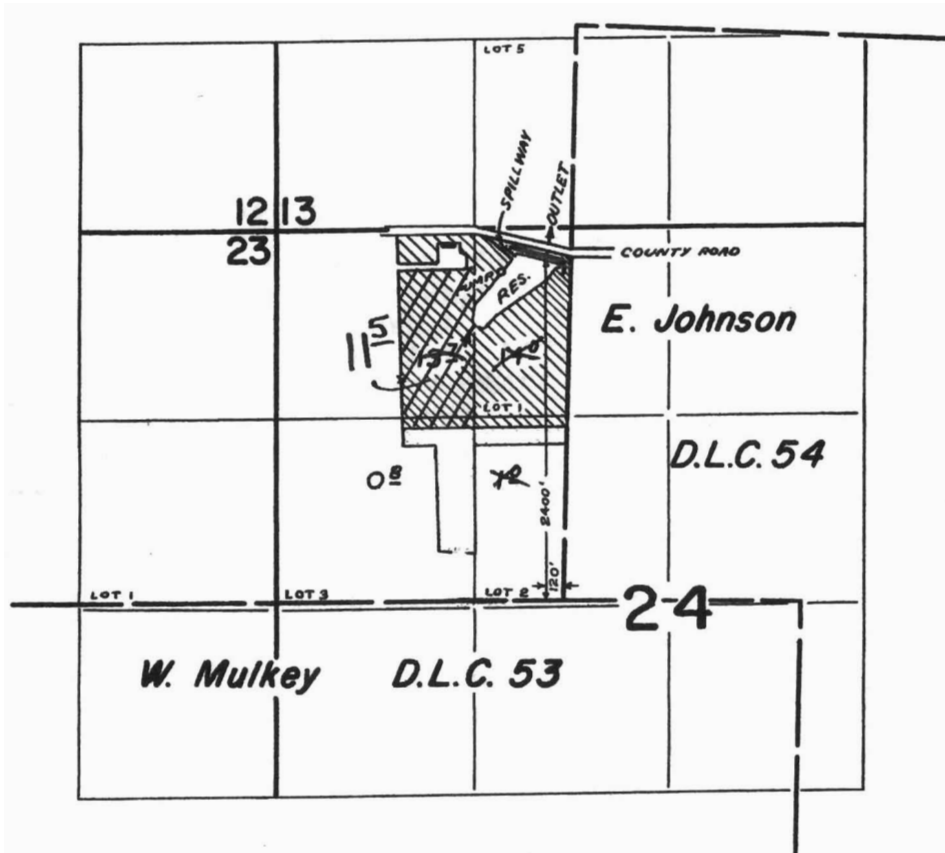

**FINAL PROOF SURVEY**  
UNDER

Application No. R-37022 37023 Permit No. R-2647 27512  
IN NAME OF

WILFRED PETERS

Surveyed May 25 1965, by M. BISH