


T.2N.R.3W.W.M.

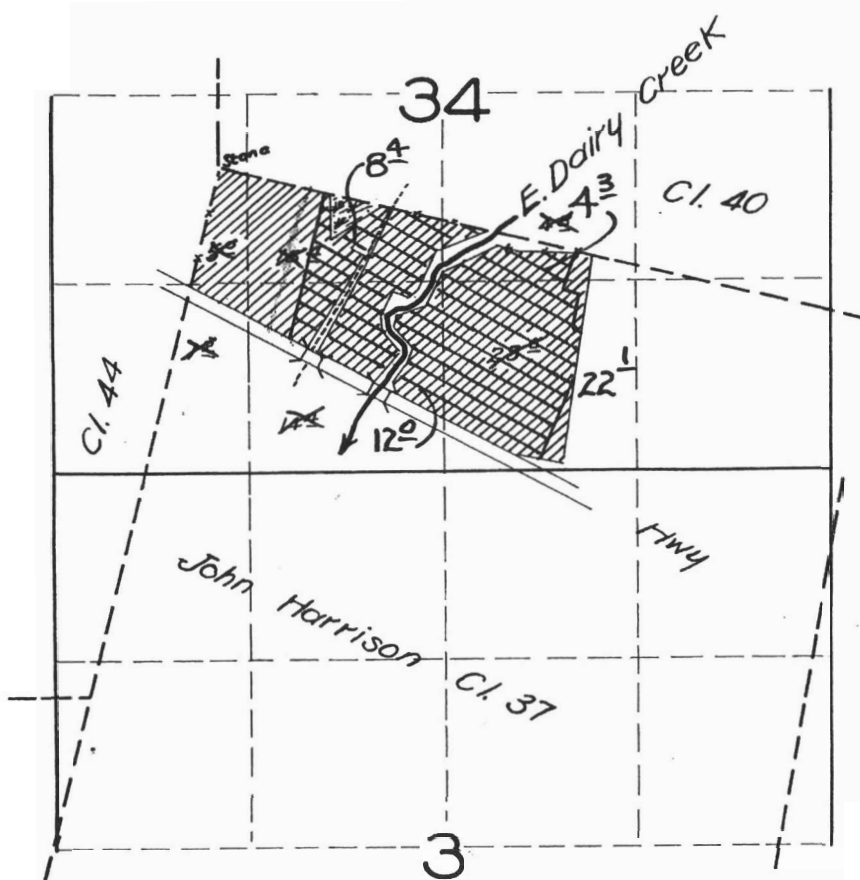

FINAL PROOF SURVEY

UNDER

Application No. 20558 Permit No. 16048

IN NAME OF

WARREN C. BAUGH

Surveyed 6 / 24 1952, by H. L. COFFMAN

RECEIVED

MAR 07 2005

WATER RESOURCES DEPT
SALEM, OREGON