


T.1N., R.3W., W.M.

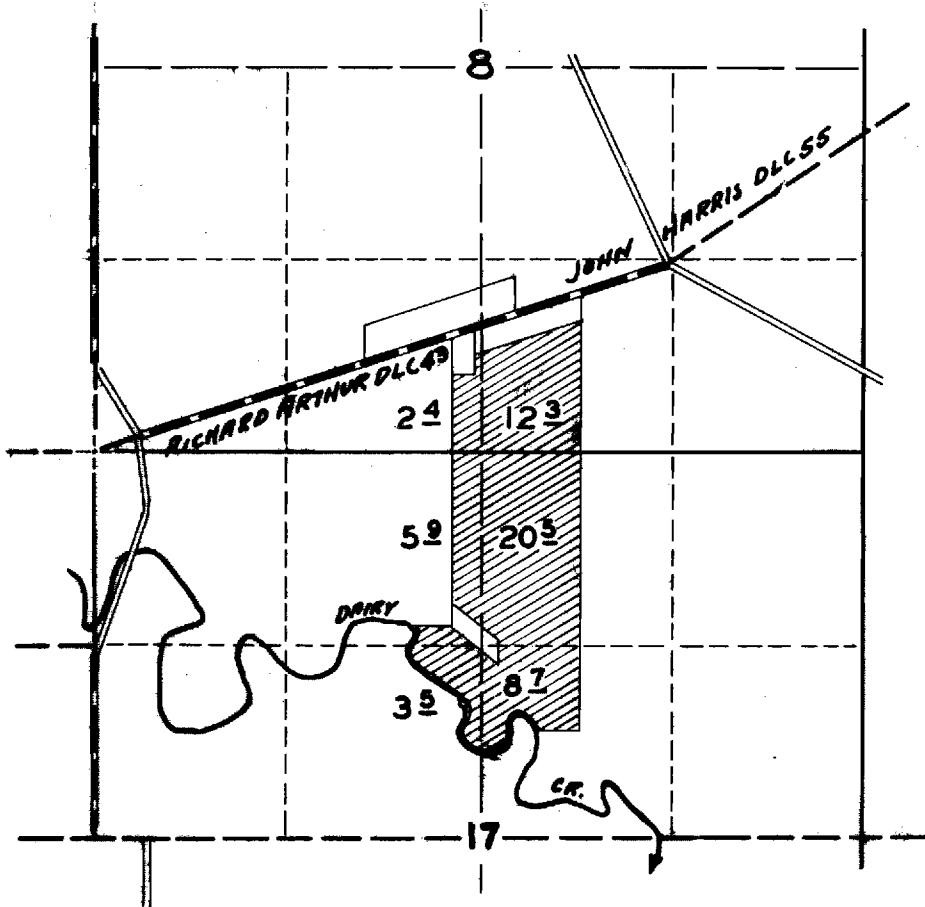

**FINAL PROOF SURVEY**

UNDER

Application No. 25107 Permit No. 19758  
IN NAME OF

**GEORGE H. VANDER ZANDE N**

Surveyed 4 - 18 1956 by R.H. WHITBY.