


T. 1 N. R. 3 W. W.M.

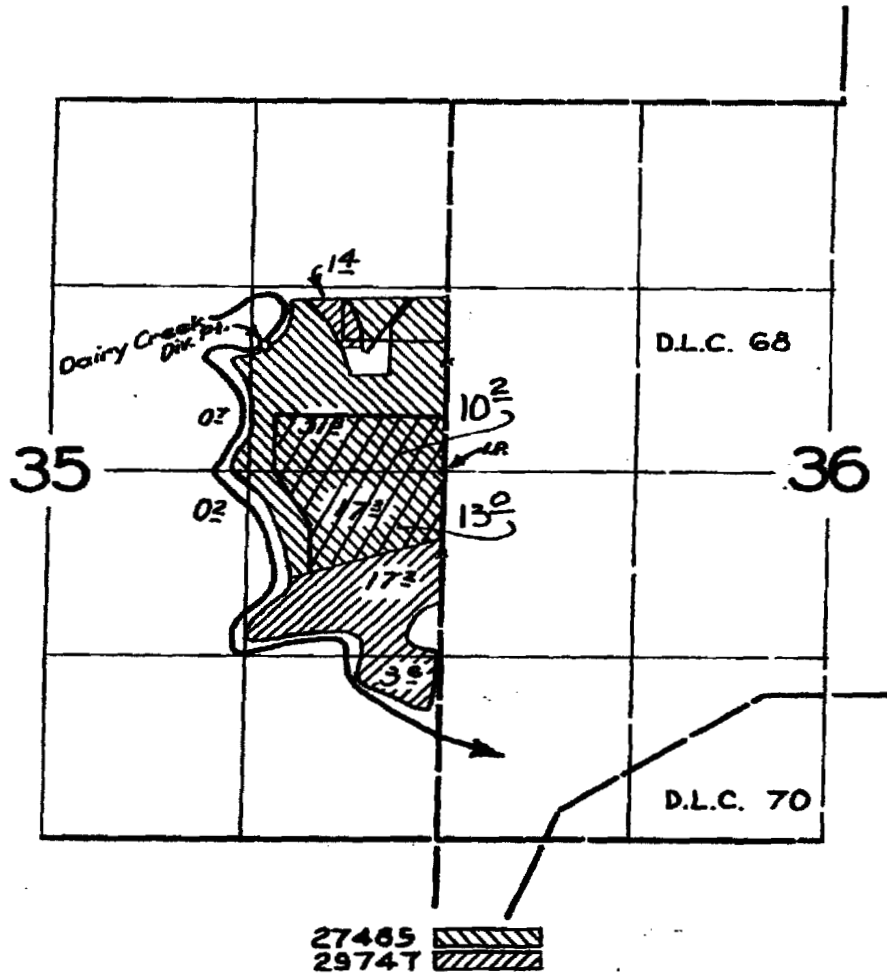

FINAL PROOF SURVEY UNDER

Application No. ²⁷⁴⁸⁵~~29747~~ Permit No. ²¹⁶³⁴~~23430~~
IN NAME OF

RAYMOND HERTEL

Surveyed 26 May 1959, by R. Jackson

RECEIVED

MAR 07 2005

WATER RESOURCES DEPT.
SALEM, OREGON