


T. 1N. R. 3W. W.M.

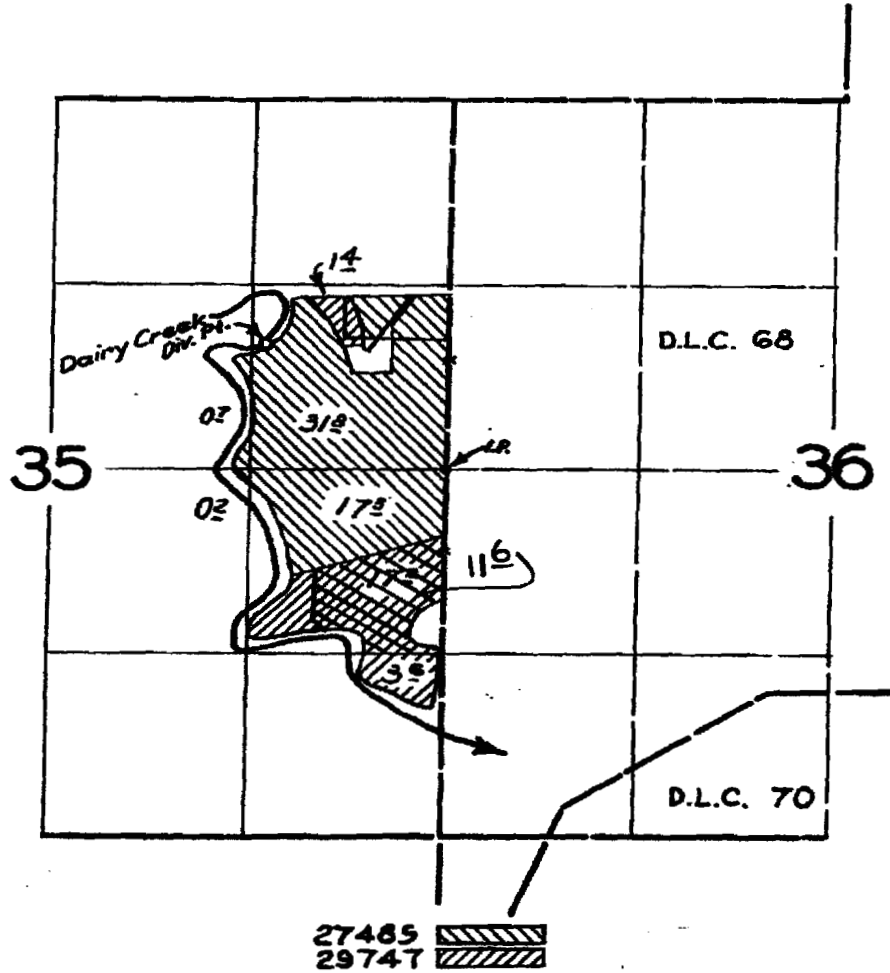

FINAL PROOF SURVEY UNDER

Application No. ²⁷⁴⁸⁵~~29747~~ Permit No. ²¹⁶³⁴~~23420~~
IN NAME OF

RAYMOND HERTEL

Surveyed 26 May 1959., by R. J. Jackson

RECEIVED

MAR 07 2005

WATER RESOURCES DEPT
SALEM, OREGON