


SECTION 14 & 23,
T.1S., R.1E., W.M.

N. LINE ALFRED LEWELLYN D.L.C.

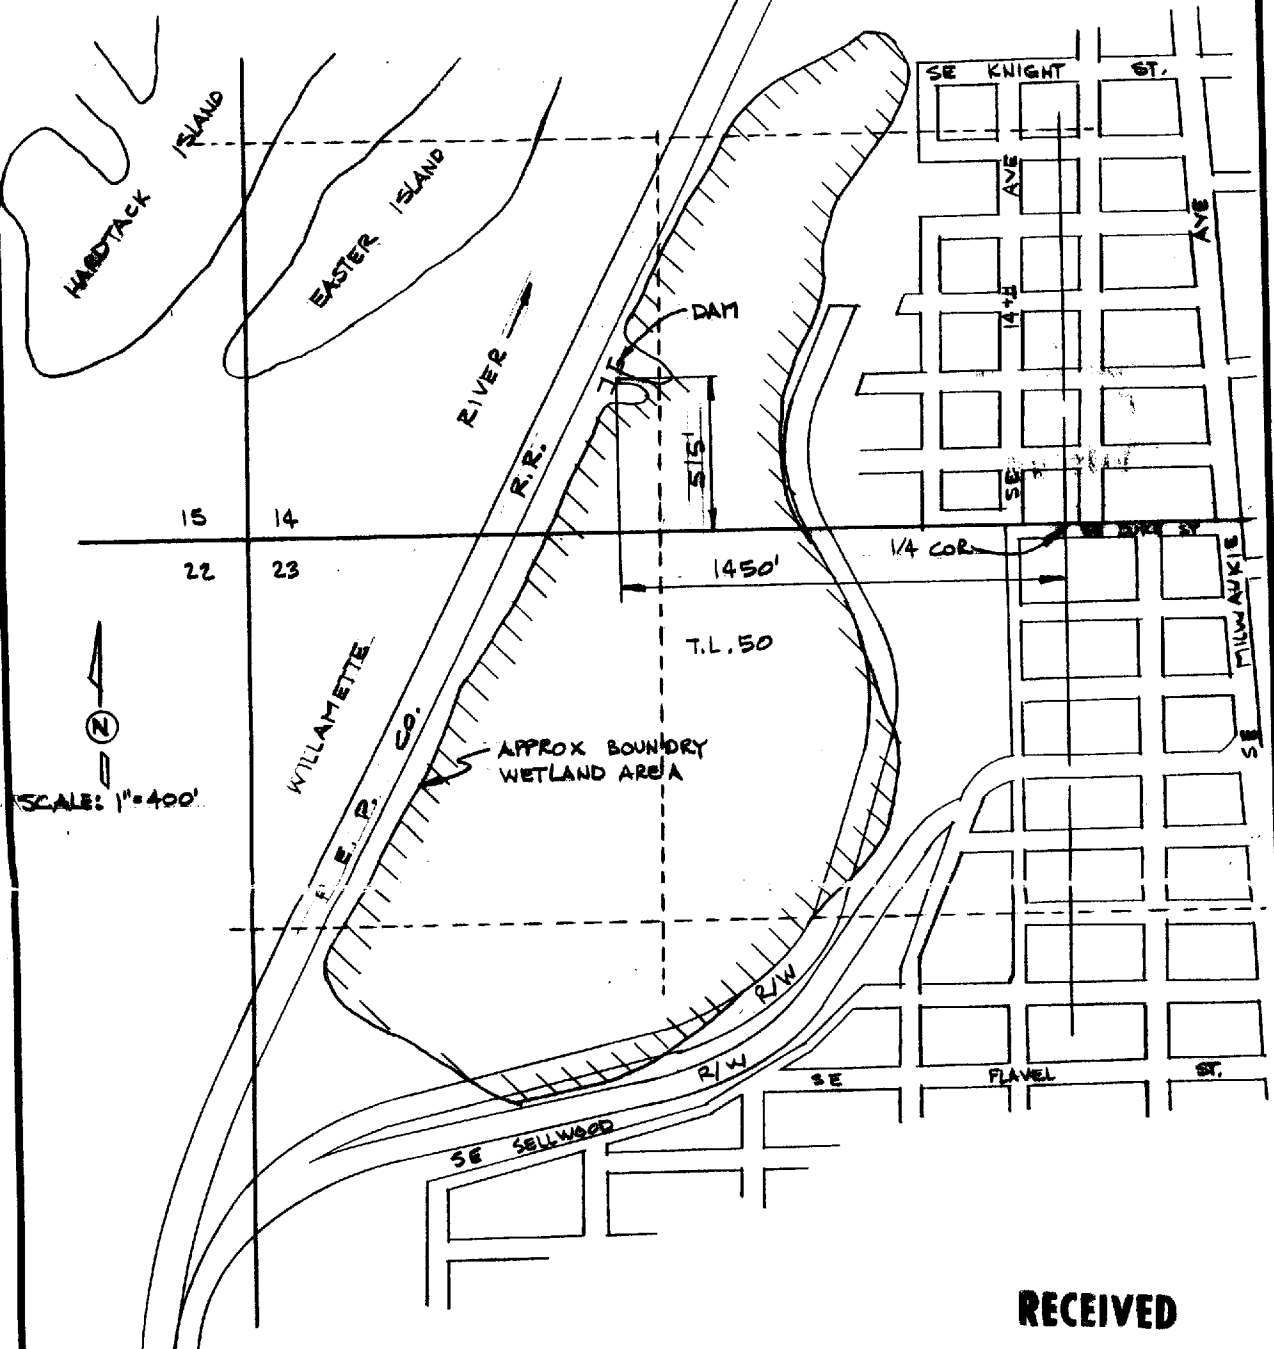

SCALE: 1"=400'

FINAL PROOF SURVEY
 SURVEYED: SEPT. 3, 1993
 PERMIT NO'S R-11233, 51018

RECEIVED

SEP 22 1993
 WATER RESOURCES DEPT.
 SALEM OREGON



PREPARATION OF THIS MAP IS FOR THE PURPOSE OF IDENTIFYING THE LOCATION OF THE WATER RIGHT ONLY. THERE IS NO INTENT TO PROVIDE DIMENSIONS OR LOCATION OF PROPERTY OWNERSHIP LINES.

VERBOORT ENGINEERING
 AGRICULTURE-CIVIL-WATER RESOURCES
 HILLSBORO, OREGON

designed	WRV	9-13-93
drawn	WRV	9-13-93
checked	WRV	9-15-93
drawing no.	93-B-19	
sheet no.	1/1	

CITY OF PORTLAND
 BUREAU OF PARKS & RECREATION