


SECTION 14 & 23,
T.1S., R.1E., W.M.

N. LINE ALFRED LEWELLYN D.L.C.

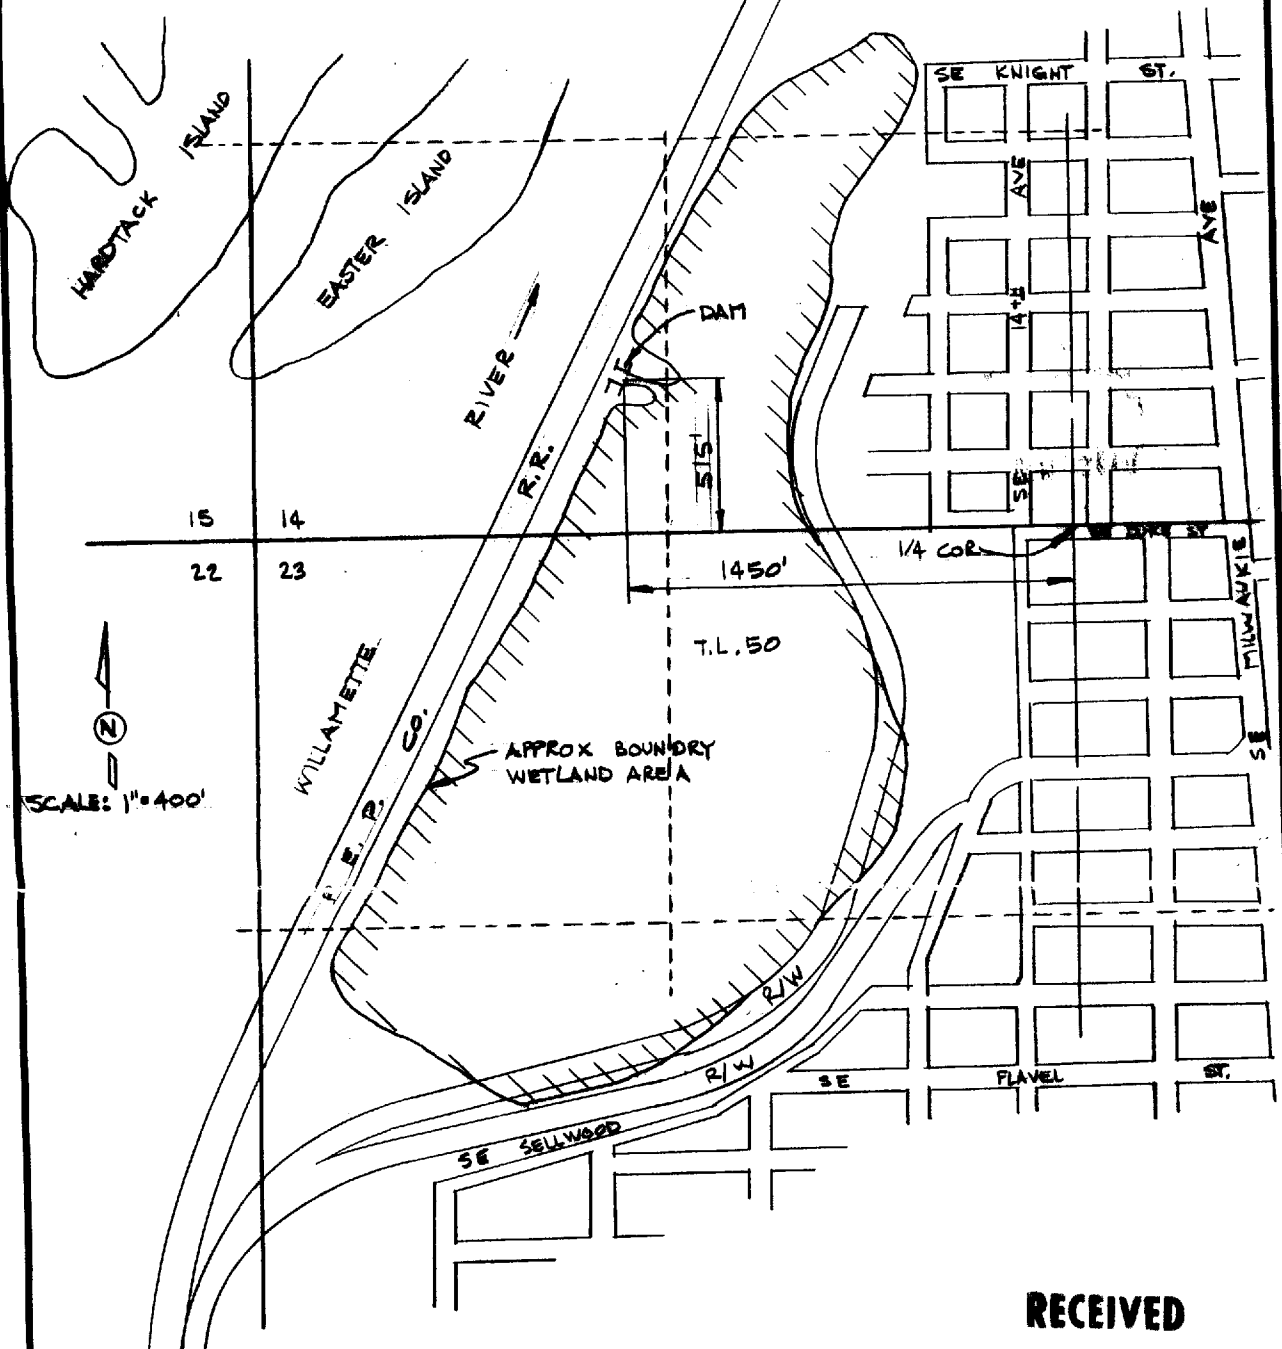


FINAL PROOF SURVEY

SURVEYED: SEPT. 3, 1893
PERMIT NO'S R-11233, 51018

RECEIVED

WATER RESOURCES DEPT.
SALEM OREGON

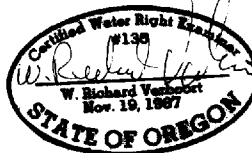

PREPARATION OF THIS MAP IS FOR THE PURPOSE OF IDENTIFYING THE LOCATION OF THE WATER RIGHT ONLY. THERE IS NO INTENT TO PROVIDE DIMENSIONS OR LOCATION OF PROPERTY OWNERSHIP LINES.

VERDOORT ENGINEERING
AGRICULTURE-CIVIL-WATER RESOURCES
HILLSBORO, OREGON

designed	WRV	9-13-93
drawn	WRV	9-13-93
checked	WRV	9-15-93
drawing no.	93-B-19	
sheet no.	1/1	

CITY OF PORTLAND
BUREAU OF PARKS & RECREATION