


27

26

Gould Pump - Size 8"x9"x11
 Style - 702A 418 Fig. 3755
 Electro Dynamic Motor.
 60 cy. - 75 H.P. 1750 RPM. - 220-440 V.
 FRAME - 445 - Type TN. Code F Des. B.
 Model AJ 4255A2 115% SF. 3 Phase.
 LIFT 59 ft.
 Est. not actual - 2100 to 2400 gal. per min.

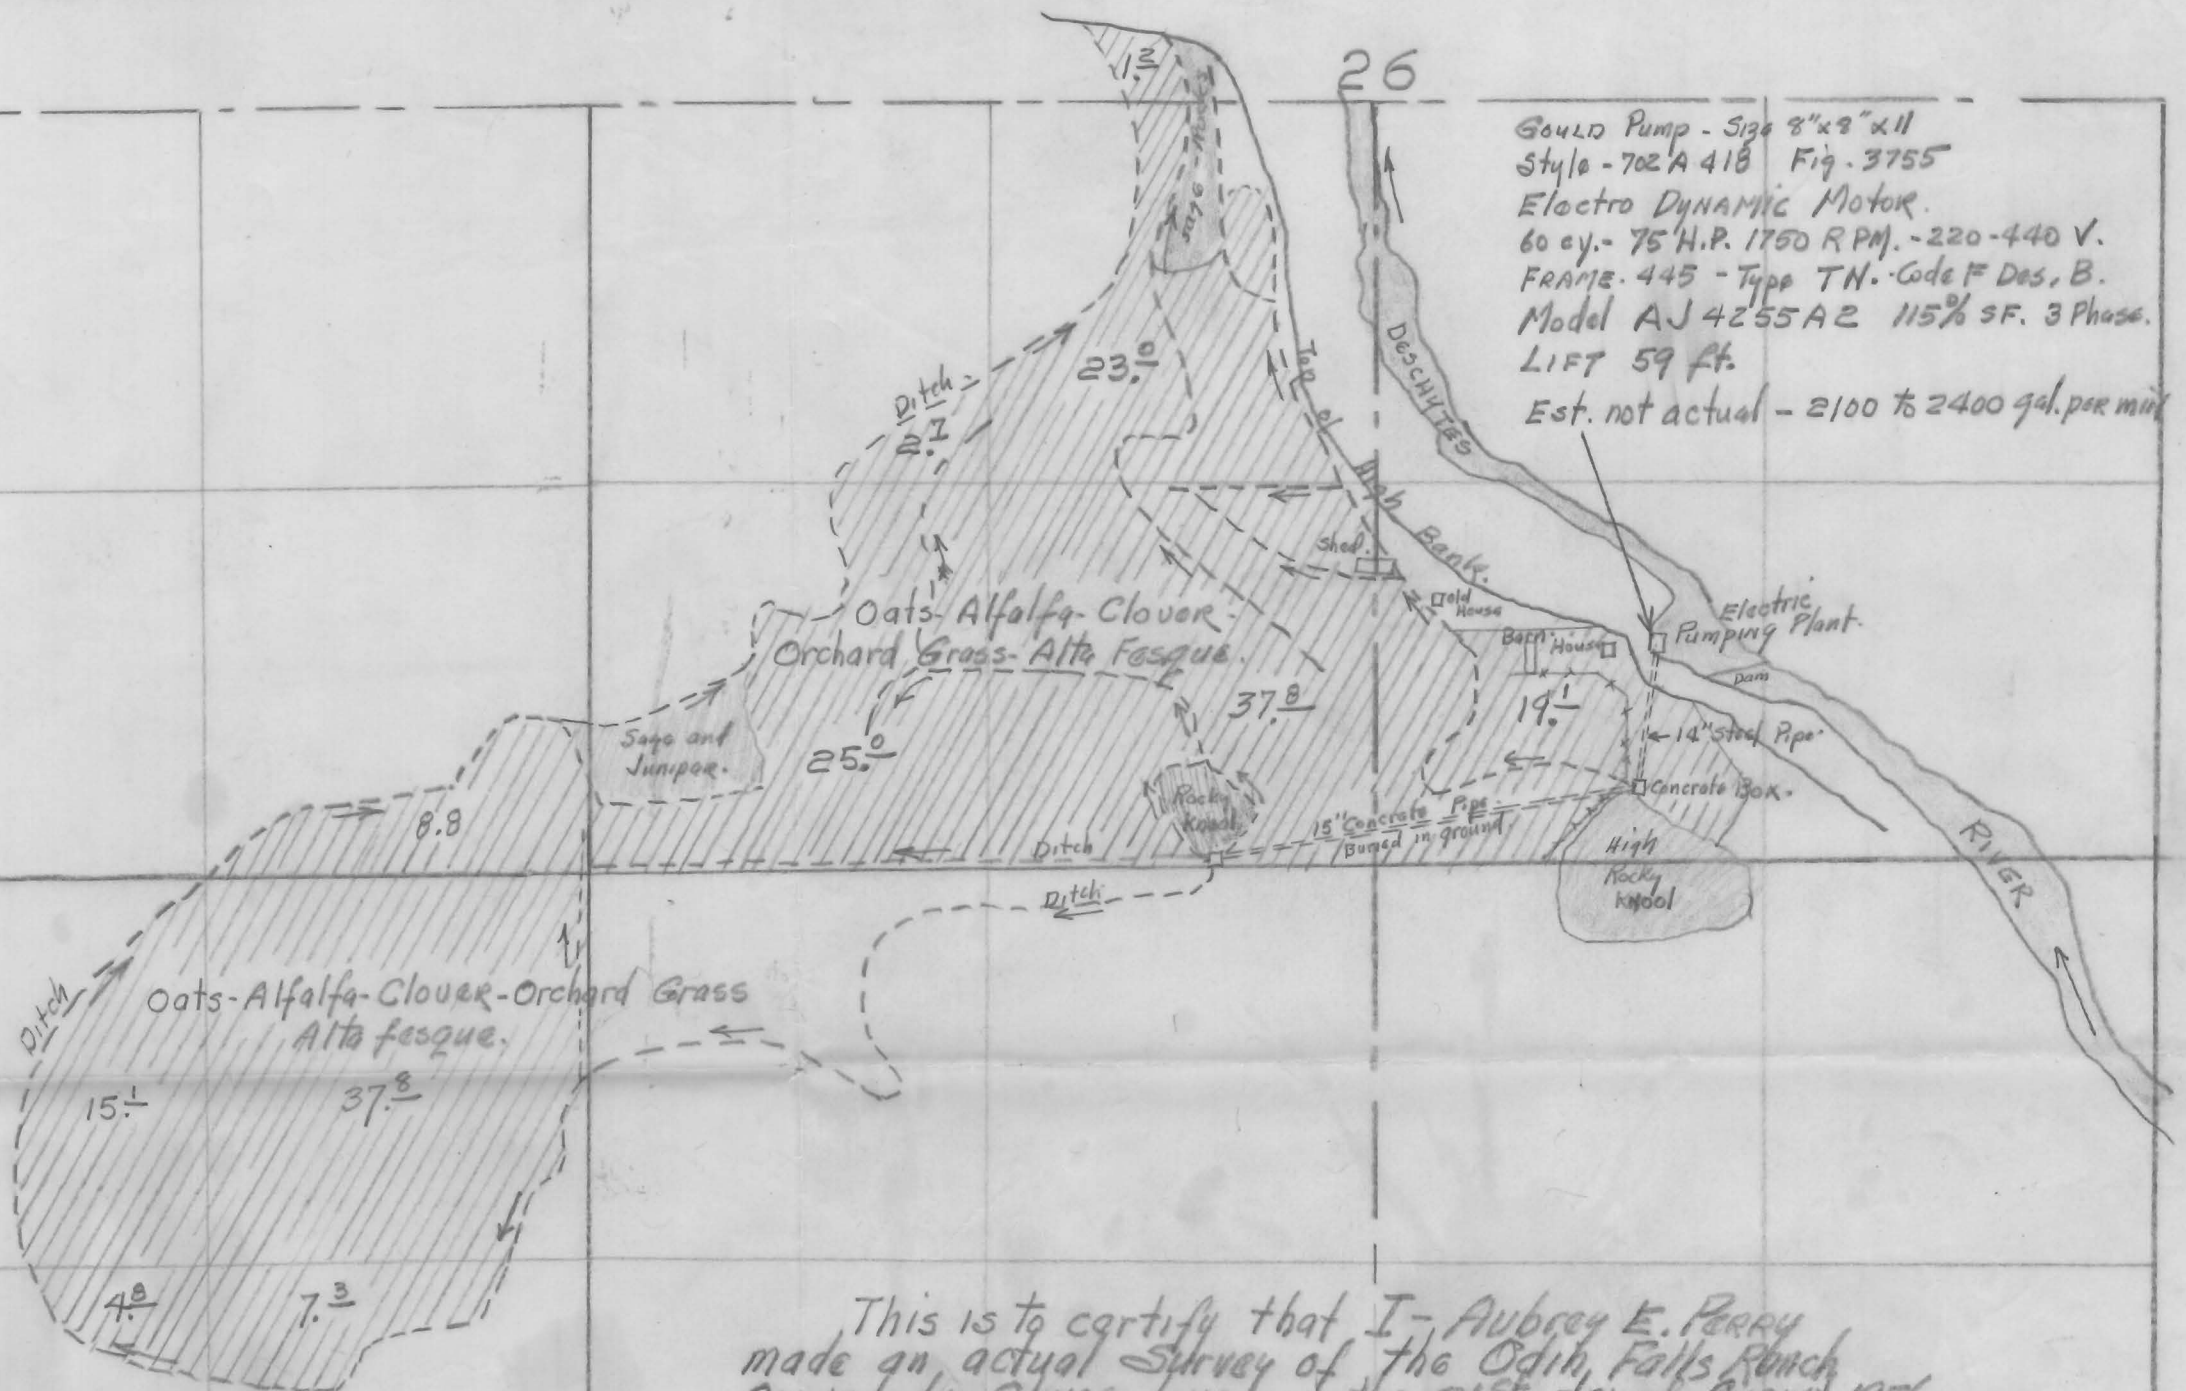

This is to certify that I - Aubrey E. Perry
 made an actual Survey of the Odin Falls Ranch
 Owned by Olive Jones on the 21st day of August 1956
 and this map shows the actual land irrigated on
 each 40 acre tract. Tp. 14 S R. 12 E. W. 17.

Scale 8" = 1 MILE.

34

35


FINAL PROOF SURVEY

UNDER

Application No. 20434 Permit No. 15920

IN NAME OF

Surveyed 19 by _____

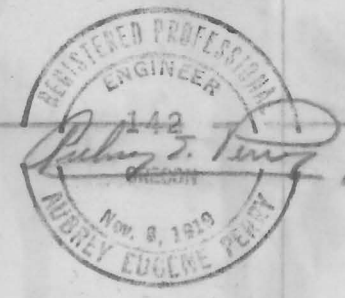

RECEIVED
 AUG 27 1956
 STATE ENGINEER
 SALEM, OREGON