


27

26

Gould Pump - Size 8"x9"x11  
 Style - 702 A 418 Fig. 3755  
 Electro Dynamic Motor.  
 60 cy. - 75 H.P. 1750 RPM. - 220-440 V.  
 FRAME - 445 - Type TN. Code F Des. B.  
 Model AJ 4255 A 2 115% SF. 3 Phase.  
 LIFT 59 ft.  
 Est. not actual - 2100 to 2400 gal. per min.

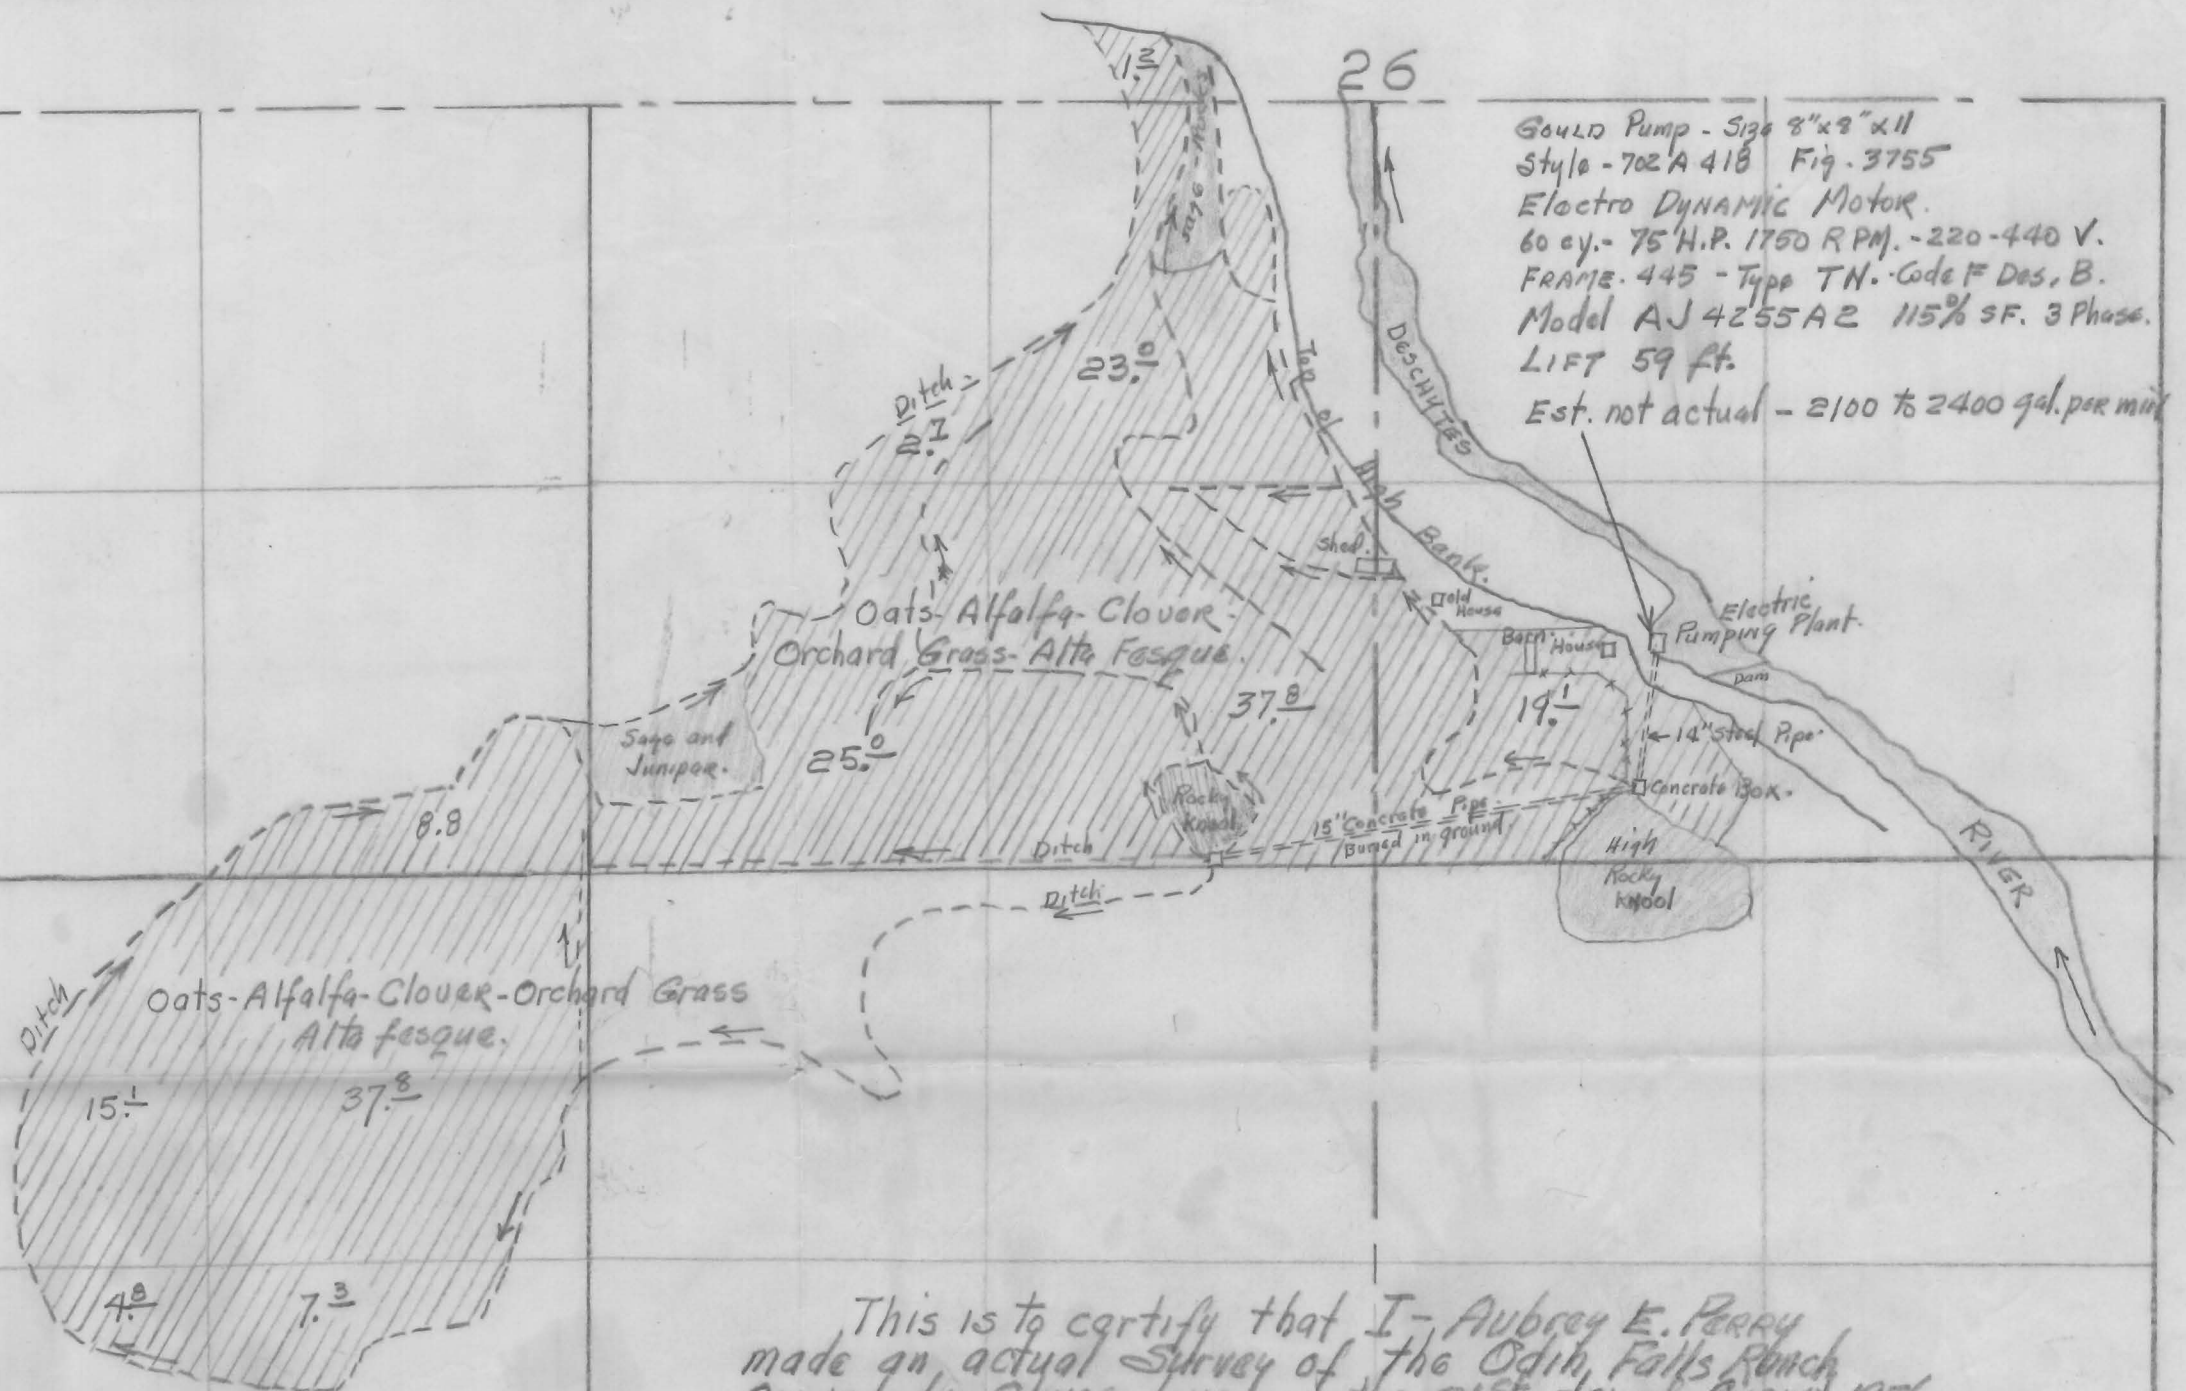

This is to certify that I - Aubrey E. Perry  
 made an actual Survey of the Odin Falls Ranch  
 Owned by Olive Jones on the 21st day of August 1956  
 and this map shows the actual land irrigated on  
 each 40 acre tract. Tp. 14 S R. 12 E. W. 17.

Scale 8" = 1 MILE.

34

35


**FINAL PROOF SURVEY**

UNDER

Application No. 20434 Permit No. 15920

IN NAME OF

Surveyed 19 by \_\_\_\_\_

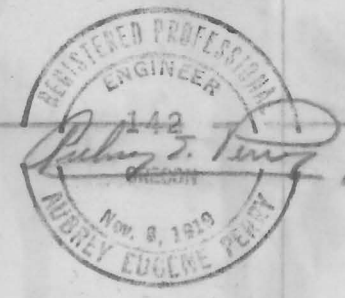

RECEIVED  
 AUG 27 1956  
 STATE ENGINEER  
 SALEM, OREGON