


T. 10 S. R. 2 W. W.M.

MAY 23 2000

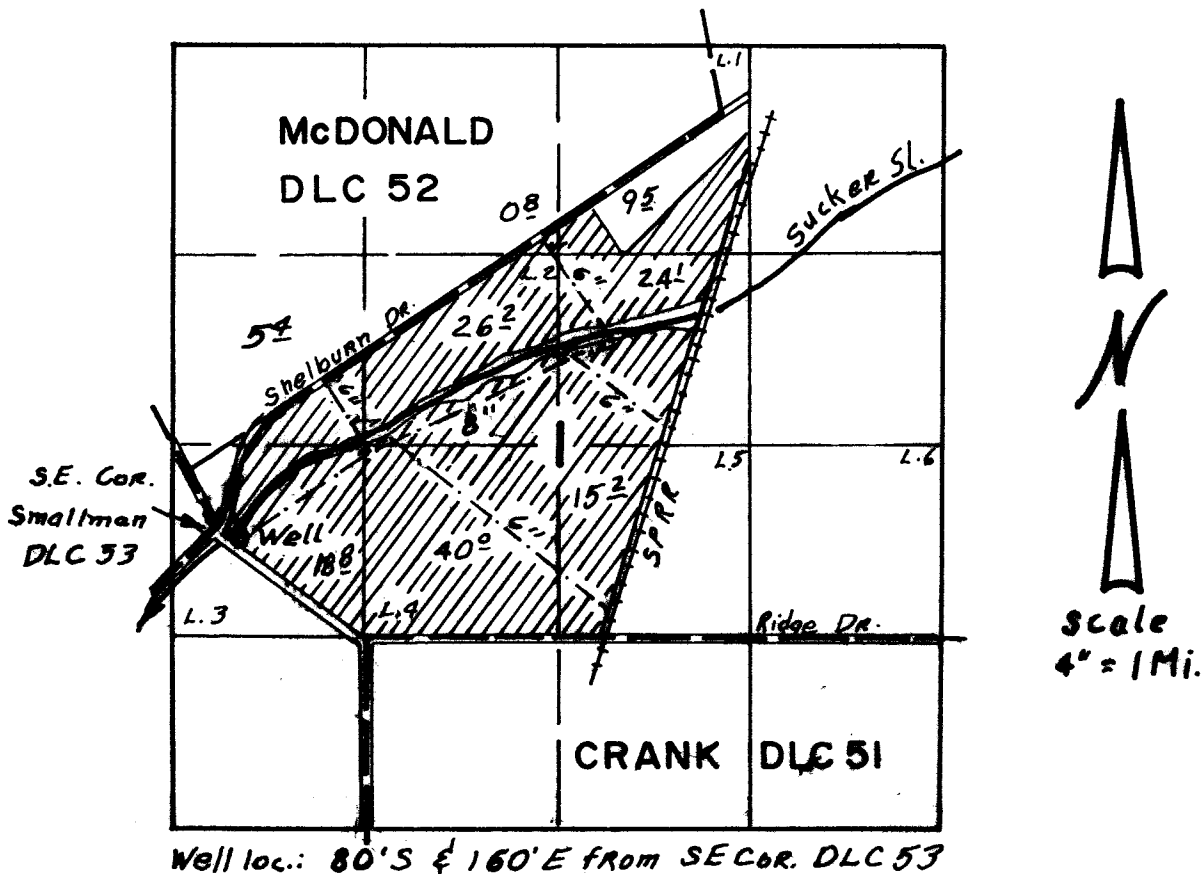


FINAL PROOF SURVEY UNDER

Application No. G-12875 Permit No. G-11740..
IN NAME OF

...M.T. JEFFERSON FARMS.....

Surveyed DEC. 30 1999., by

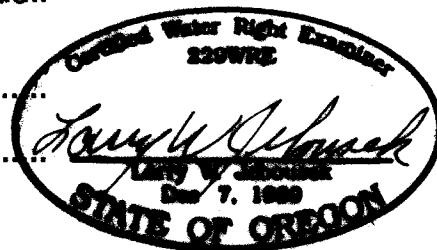

THIS MAP WAS PREPARED FOR THE PURPOSE OF IDENTIFYING THE LOCATION OF A WATER RIGHT ONLY AND IS NOT INTENDED TO PROVIDE LEGAL DIMENSIONS OR LOCATION OF PROPERTY OWNERSHIP LINES.

WAC-980V 4-227