

A PORTION OF THE SW $\frac{1}{4}$, SE $\frac{1}{4}$,
SECTION 34, TIN, RIE, W.M.
TOGETHER WITH A PORTION OF THE
N $\frac{1}{2}$, SECTION 3, T1S, R1E, W.M.

CLAIM OF BENEFICIAL USE MAP WATERFRONT PARK

APPLICATION G-14498, PERMIT G-13394

IN THE NAME OF
THE CITY OF PORTLAND
PARKS AND RECREATION

SITUATED IN TAX LOTS 100, 3600, 3700,
3800, AND 3900, SW $\frac{1}{4}$, SE $\frac{1}{4}$, SECTION 34,
TIN, RIE, W.M.; AND IN TAX LOTS 100, 8500,
8600, AND 8700, NE $\frac{1}{4}$, NW $\frac{1}{4}$, SECTION 3,
T1S, R1E, W.M., CITY OF PORTLAND,


MULTNOMAH COUNTY, OREGON

SURVEY COMPLETED FEBRUARY 10, 2004

BY DAN A. BUTTS, CURE
FOR CITY OF PORTLAND

LEGEND:


-  SECTION LINE
-  $\frac{1}{4}$ $\frac{1}{4}$ SECTION LINE
-  PROPERTY LINE
-  IRRIGATION MAINLINE
-  EXISTING IRRIGATED AREA
FROM WELL AS PER PERMIT
NO. G-13394 WITH GRASS LAWN.
(HATCHURE ANGLE CHANGES
BY SECTIONAL SUBDIVISION)

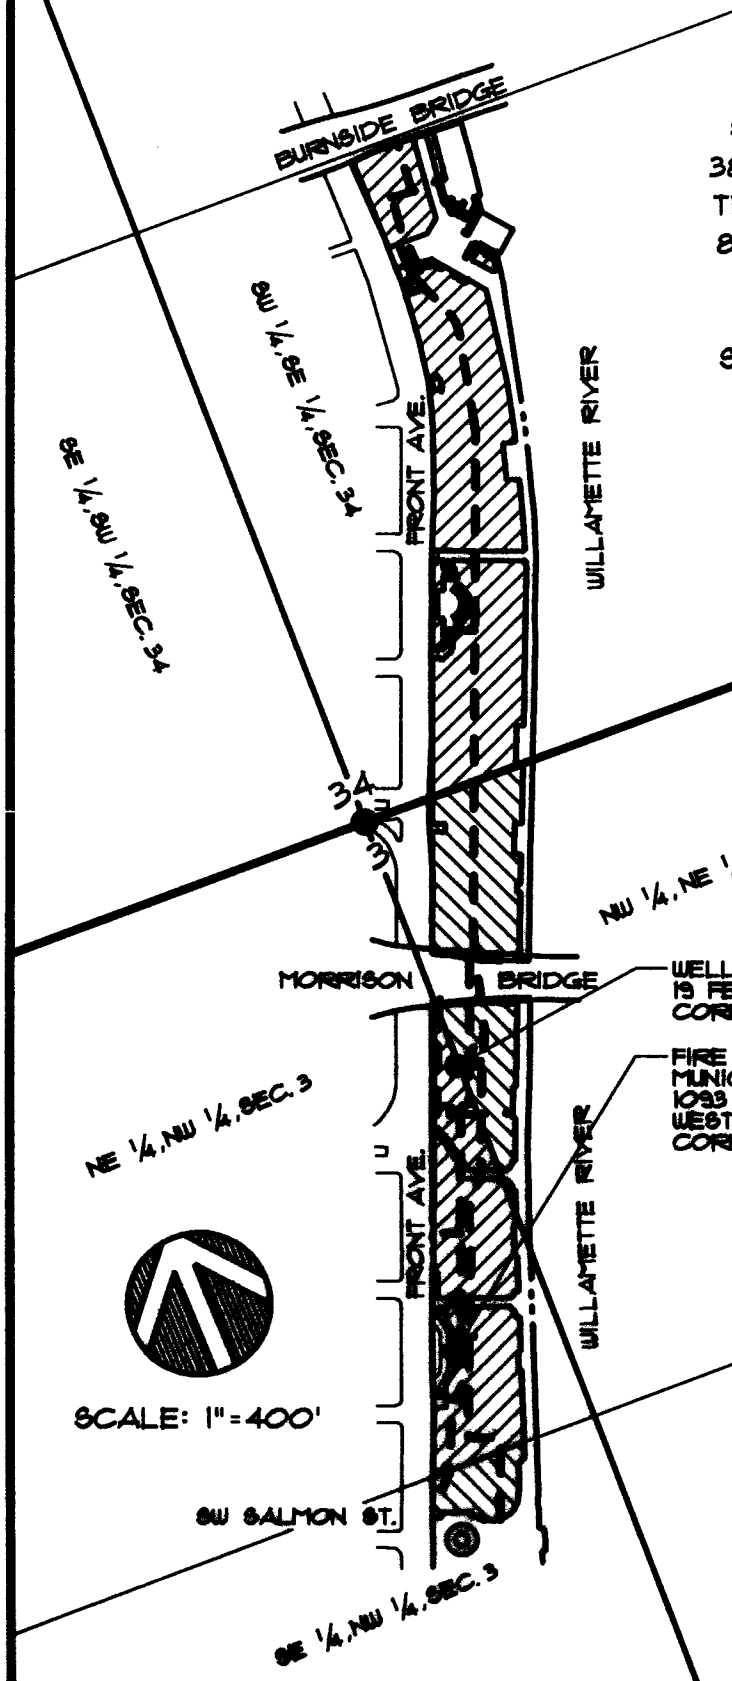

RECEIVED

DEC 07 2004

WATER RESOURCES DEPT
SALEM, OREGON

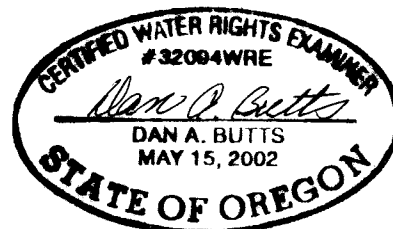

EXPIRATION DATE: 12/31/05

THIS MAP IS TO IDENTIFY A PROPOSED
WATER RIGHT LOCATION. IT IS NOT TO BE
USED TO LOCATE PROPERTY BOUNDARIES.