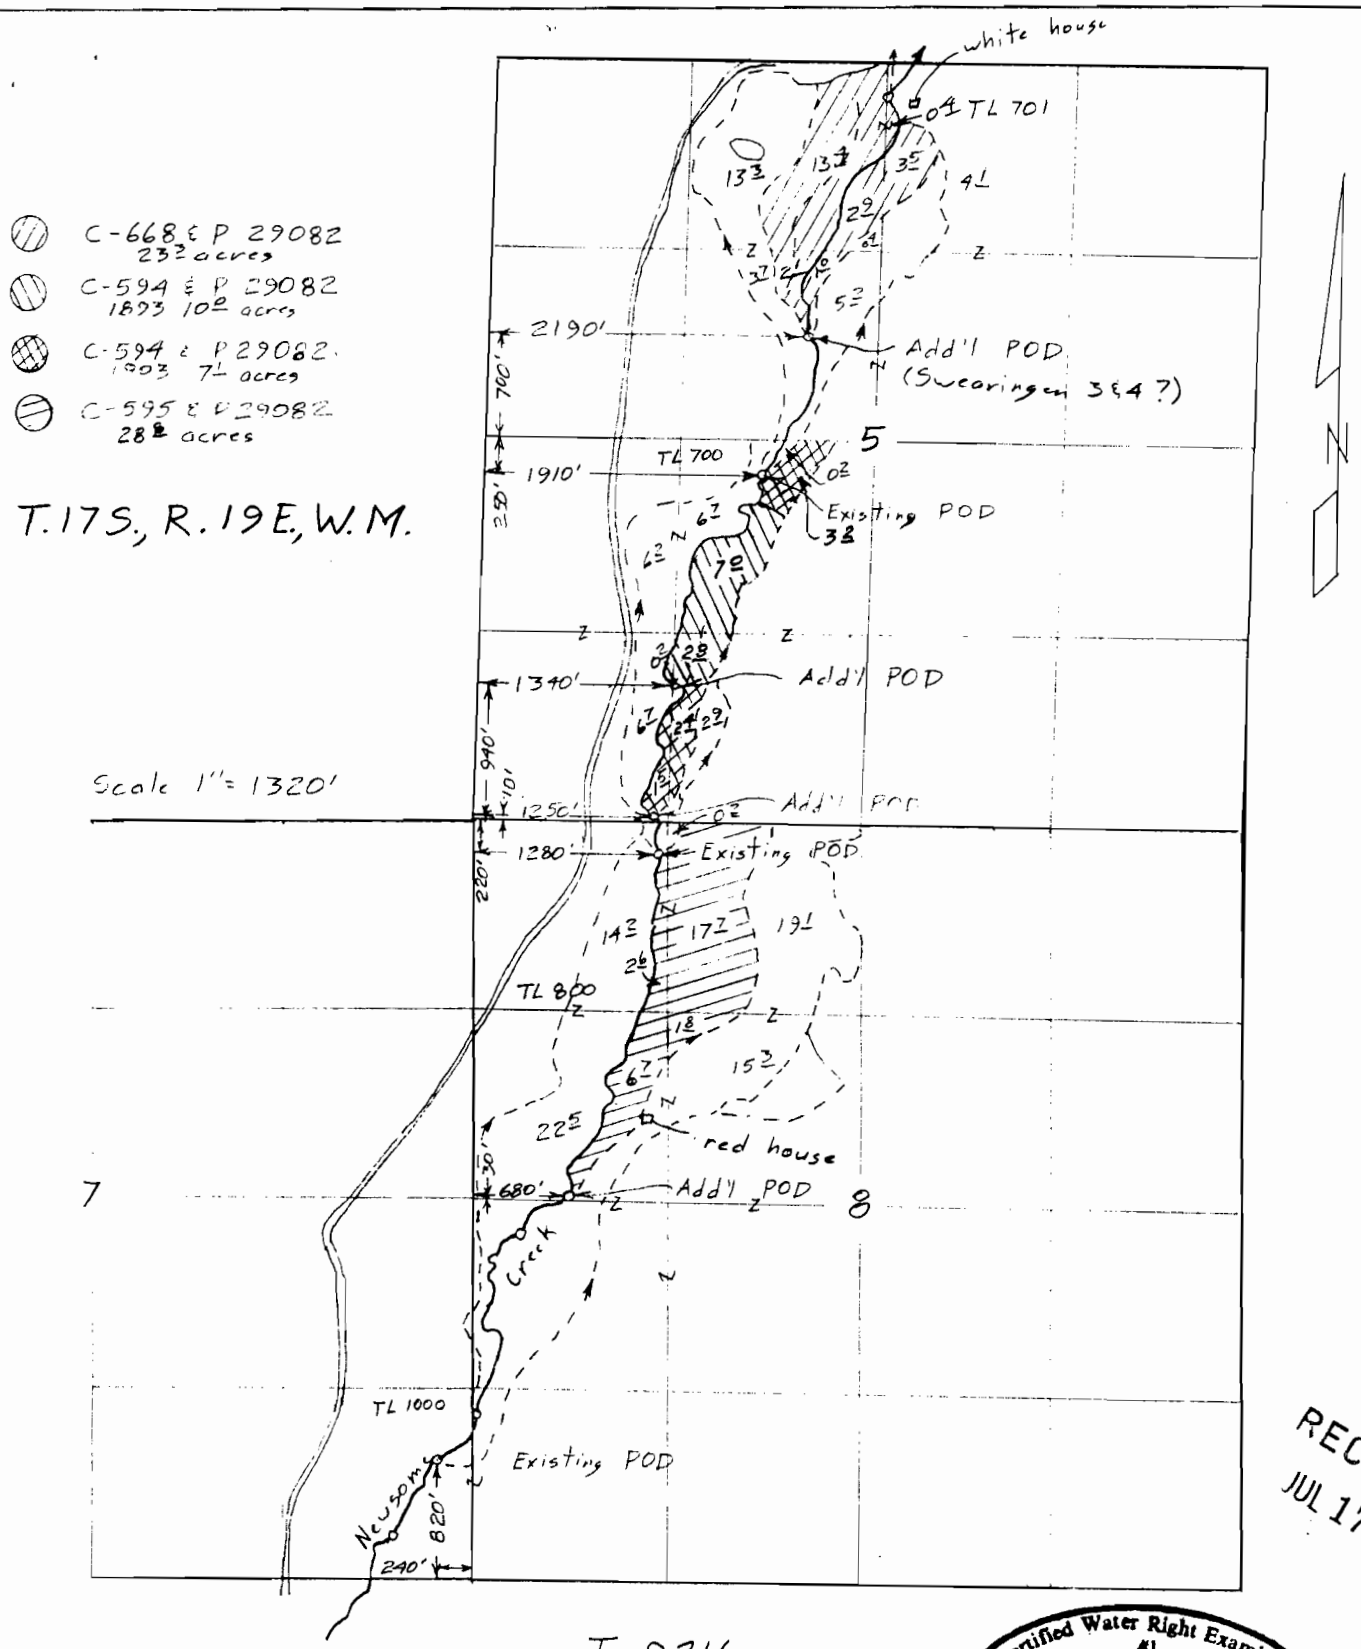

T-9216

Application Map
for
ASPEN VALLEY RANCH

This map is for the purpose of locating a water right only and has no intent to provide legal dimensions or the location of property lines.

RECEIVED
JUL 17 2006

Certified Water Right Examiner
#1
Bruce A. Estes
Nov. 19, 1987
STATE OF OREGON

Renewal Dec 31, 2007

Sheet 2 of 2

ESTES SURVEYS, LLC

~~PO Box 17519~~
Salem, OR 97305-7519
(503) 585-7593

60382 Arnold Rd
Bend, OR 97702
(541) 382-7391

Amended June 7, 2006