


T1S, R3W, WM

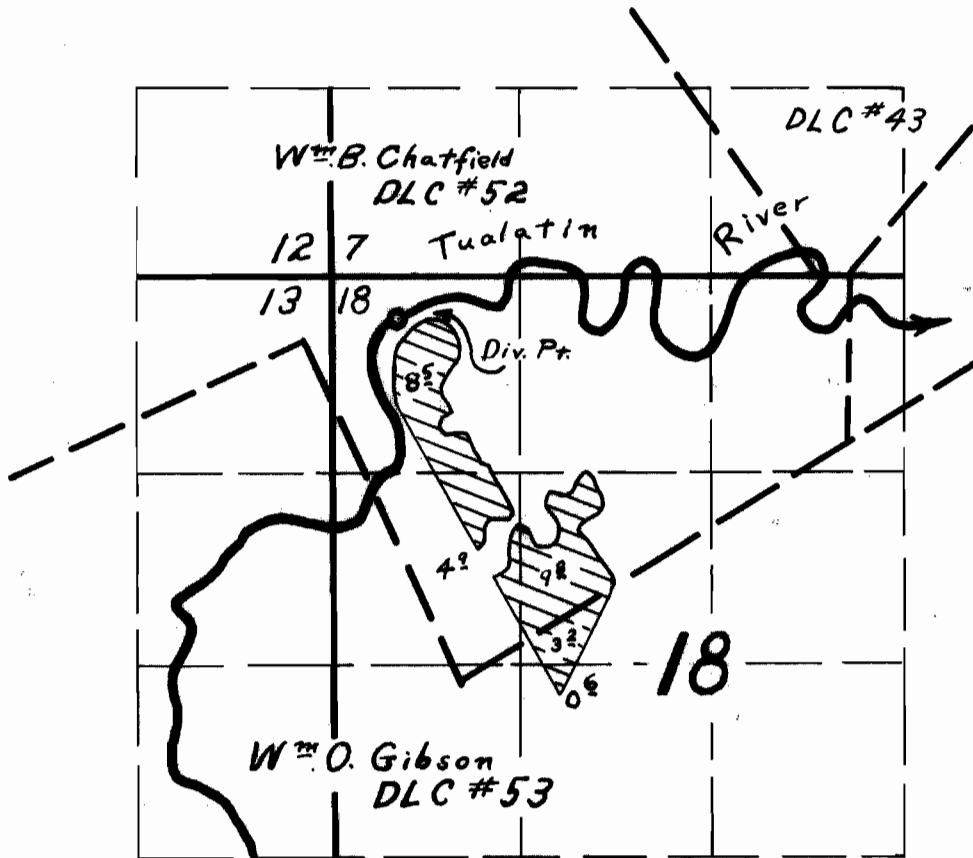

FINAL PROOF SURVEY
UNDER

Application No. 25512 Permit No. 20043
IN NAME OF

ALFRED C. & A. E. HUTCHINSON

Surveyed 5-17 1956, by R.P. Best