


T. 30 S., R. 5 W., W. M.

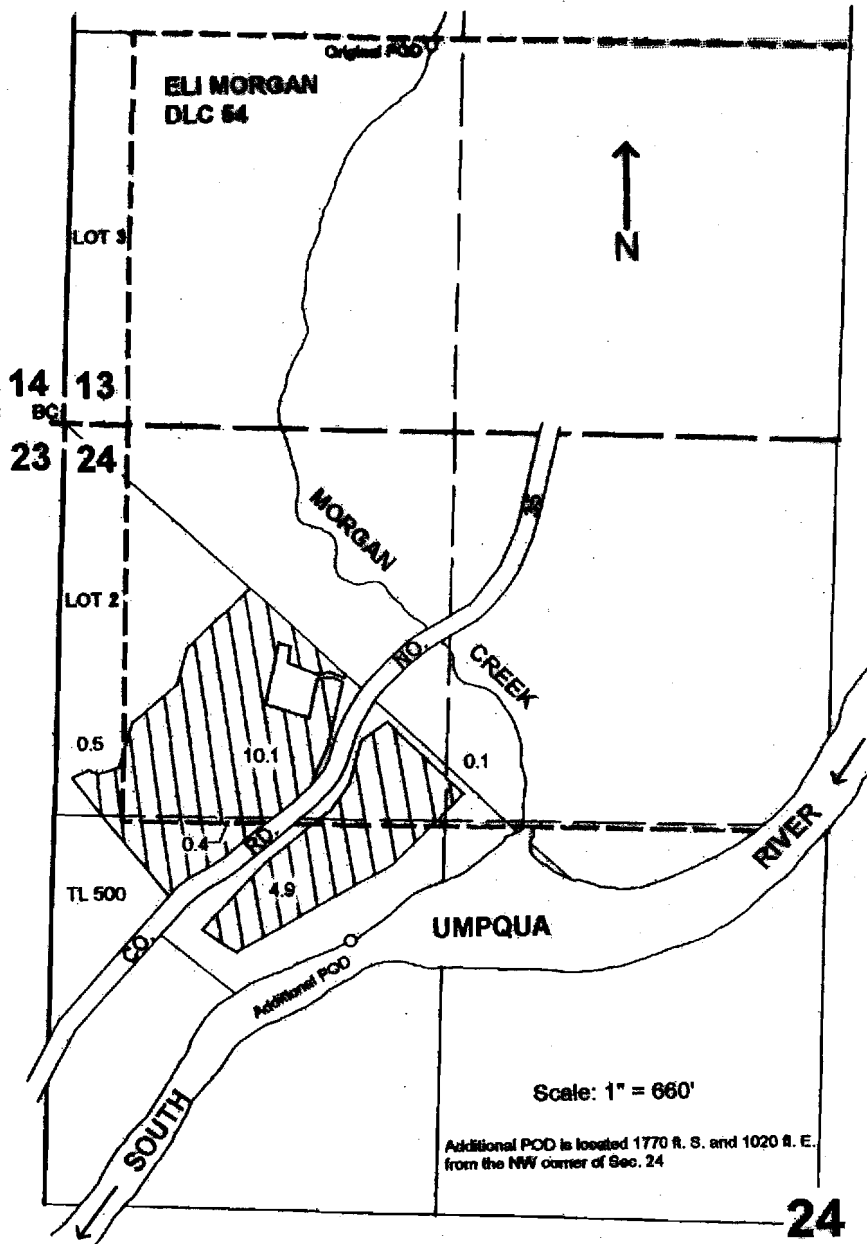

FINAL PROOF SURVEY UNDER

Transfer 5772

IN NAME OF
Webster Briggs

Surveyed April 1, 2005, by D.S. Williams