



FINAL PROOF MAP - PERMIT G-12858


APPLICATION G-13536

LOCATED IN THE SE 1/4 OF THE SE 1/4 OF
SECTION 10, T. 15 S., R. 12 E., W.M.
DESCHUTES COUNTY, OREGON

RECEIVED

SEP 27 2001


**WATER RESOURCES DEPT.
SALEM, OREGON**

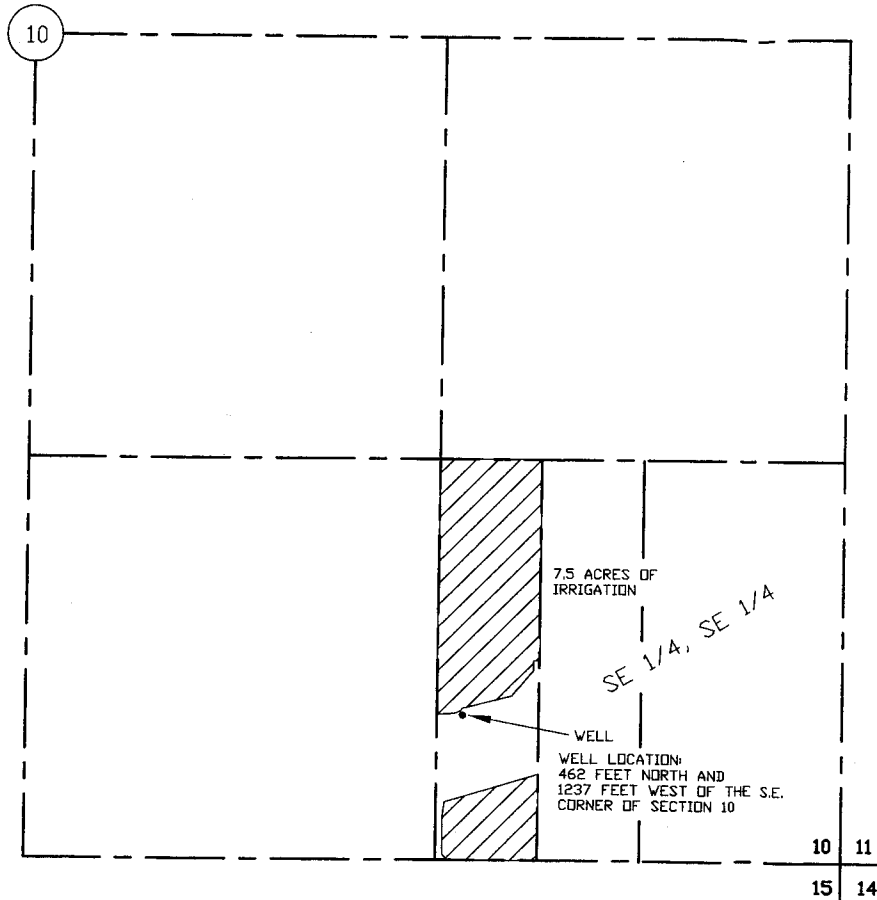

I, ROBERT E. BAXTER, CERTIFIED WATER RIGHT EXAMINER
IN THE STATE OF OREGON, HEREBY CERTIFY THAT THIS
WATER RIGHT SURVEY MAP WAS PREPARED BY ME.

THE PREPARATION OF THIS MAP IS FOR THE PURPOSE
OF IDENTIFYING THE LOCATION OF THE WATER RIGHT
ONLY AND HAS NO INTENT TO PROVIDE DIMENSIONS OR
LOCATIONS OF PROPERTY OWNERSHIP LINES.

 = IRRIGATED AREA
7.5 ACRES

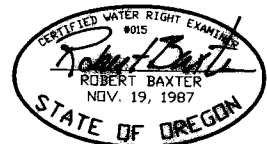


PREPARED BY
BAXTER LAND SURVEYING, INC.
20370 EMPIRE AVE. SUITE C3
BEND, ORE. 97701 (541) 382-1962

**FINAL PROOF MAP
FOR
KERMIT AND MARGARET BOTHUM**

PREPARED FOR: KERMIT & MARGARET BOTHUM
8531 W. ANTLER
REDMOND, OREGON 97756 (541)-548-4426
SCALE: 1" = 400'
DATE: 9-24-01

FINAL PROOF MAP - PERMIT G-12858
APPLICATION G-13536

LOCATED IN THE SE 1/4 OF THE SE 1/4 OF
 SECTION 10, T. 15 S., R. 12 E., W.M.
 TAX LOT 15-12-10-2303, DESCHUTES COUNTY, OREGON

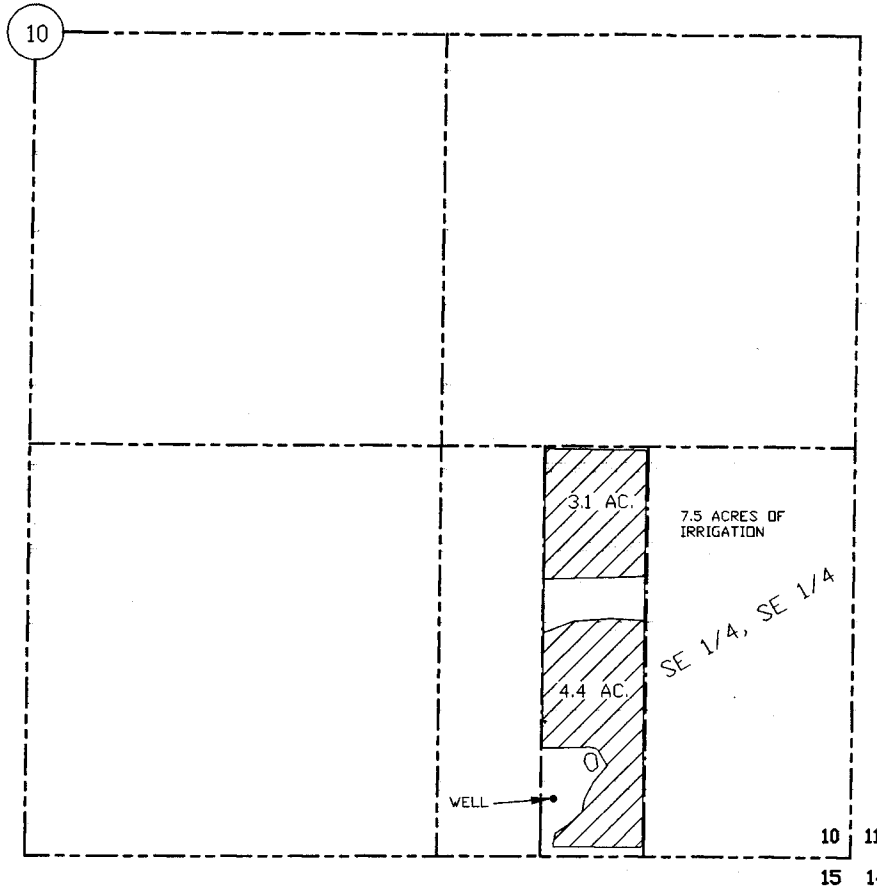

NOTES:

A PARTIAL ASSIGNMENT OF THIS PERMIT
 WAS RECORDED TO PATRICK AND CHERYL
 FLESCH PER WATER RESOURCES LETTER
 DATED OCT. 25th, 2000.

THE WELL LOCATION IS 194 FEET NORTH
 AND 953 FEET WEST OF THE SOUTHEAST
 CORNER OF SECTION 10.

I, ROBERT E. BAXTER, CERTIFIED WATER RIGHT EXAMINER
 IN THE STATE OF OREGON, HEREBY CERTIFY THAT THIS
 WATER RIGHT SURVEY MAP WAS PREPARED BY ME.


THE PREPARATION OF THIS MAP IS FOR THE PURPOSE
 OF IDENTIFYING THE LOCATION OF THE WATER RIGHT
 ONLY AND HAS NO INTENT TO PROVIDE DIMENSIONS OR
 LOCATIONS OF PROPERTY OWNERSHIP LINES.

 = IRRIGATED AREA
 7.5 ACRES

RECEIVED

MAR 26 2003

WATER RESOURCES DEPT.
 SALEM, OREGON

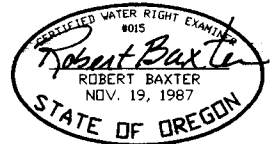

PREPARED BY
 BAXTER LAND SURVEYING, INC.
 20370 EMPIRE AVE. SUITE C3
 BEND, ORE. 97701 (541) 382-1962

FINAL PROOF MAP
FOR
PATRICK & CHERYL FLESCH

PREPARED FOR: PATRICK & CHERYL FLESCH
 8515 W. ANTLER
 REDMOND, OREGON 97756 (541)-923-4959
 SCALE: 1" = 400'
 DATE: 3-13-03