


RECEIVED

JUL 12 1996

UNITED STATES WATER RESOURCES DEPT.
DEPARTMENT OF THE INTERIOR OREGON
GEOLOGICAL SURVEY

RECEIVED
JAN - 4 1996

270 IN SE
(STINKING LAKE)

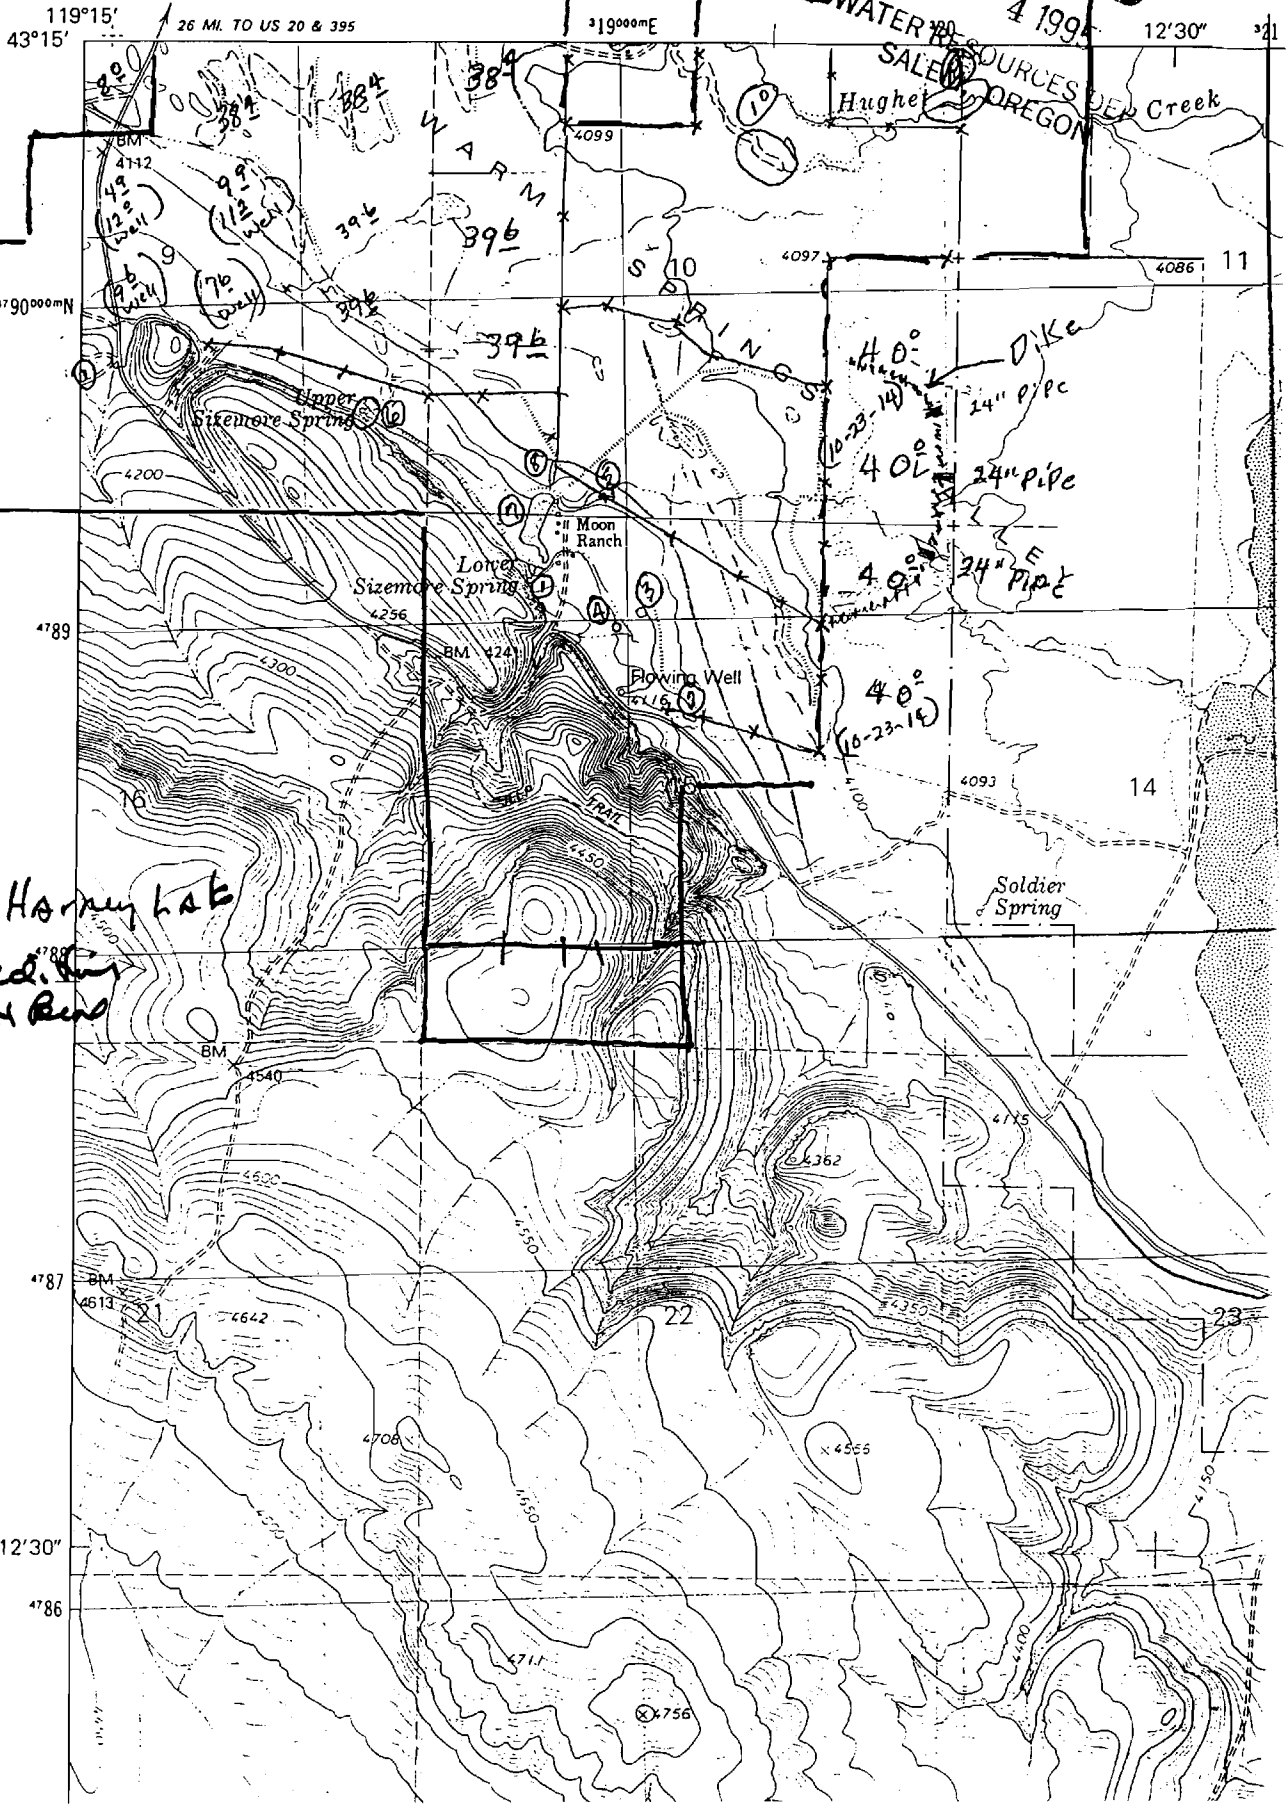

Application No. 83396
Permit No. 80722
Certifica

South west Harney Lake
1980 edition
W N BIRD

T-27-S
R-29-E